


T.4S.R.13W.WM

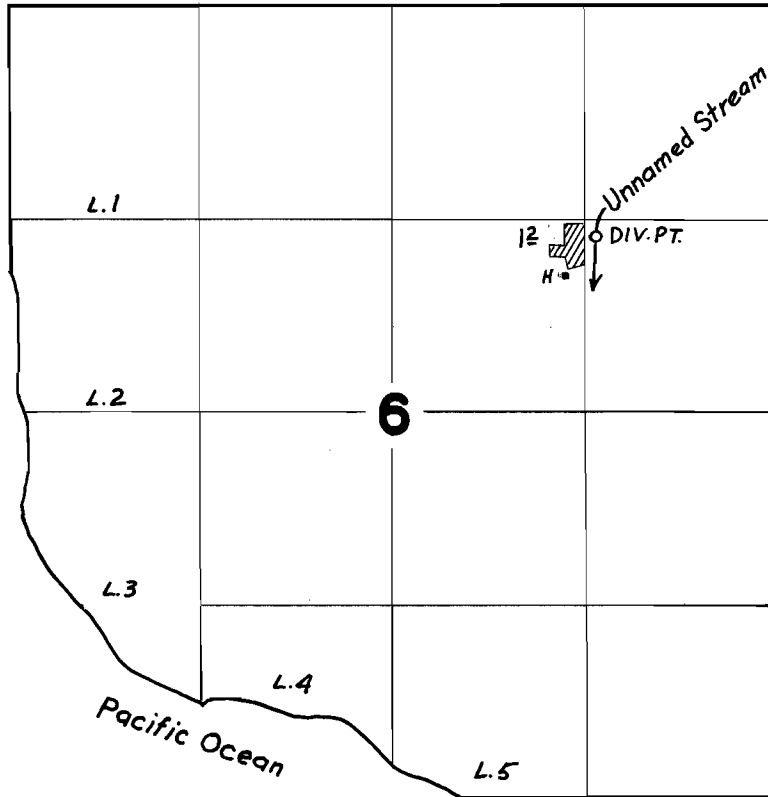

FINAL PROOF SURVEY

UNDER

Application No. 23201 Permit No. 18273

IN NAME OF

J.E. Stevenson

Surveyed Sept 16 1953, by T. Jones