


T.15S.R.12W.WM

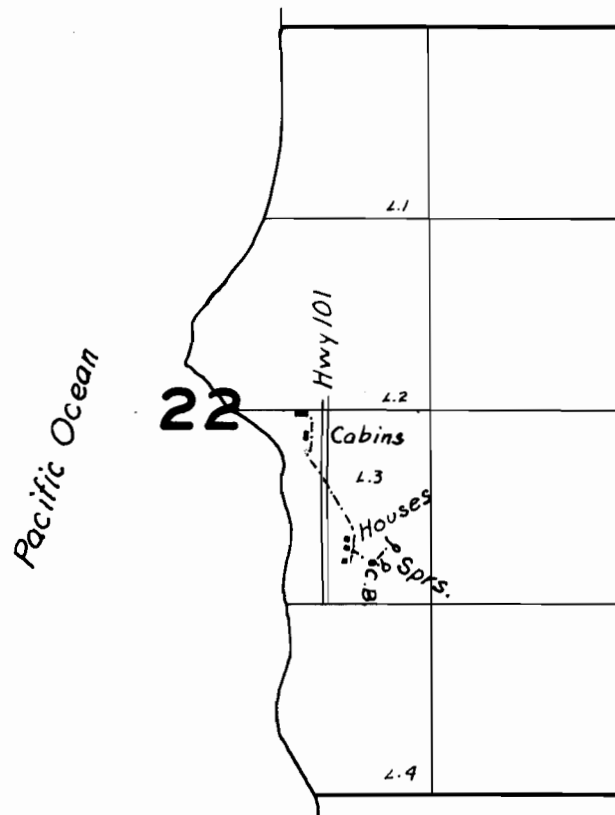

FINAL PROOF SURVEY
UNDER

Application No. 22325 Permit No. 1
IN NAME OF

John Ambulfer

Surveyed 1919.54, by J. Ambulfer