


T.13S. R.1E & W.W.M.

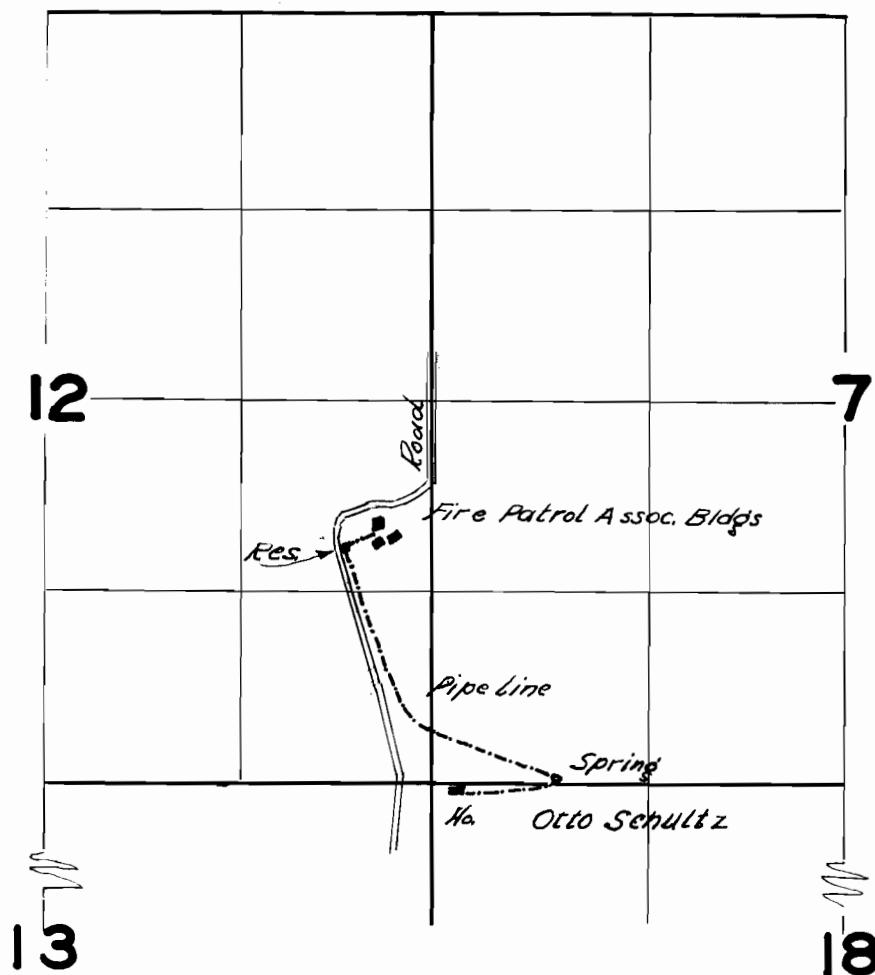

FINAL PROOF SURVEY

UNDER

Application No. 23359 23401 Permit No. 18633 18474

IN NAME OF

Otto Schultz

Linn County Fire Patrol Association

Surveyed Aug. 18, 1954, by H. L. Coffman