


# T.6S.R.3W.WM

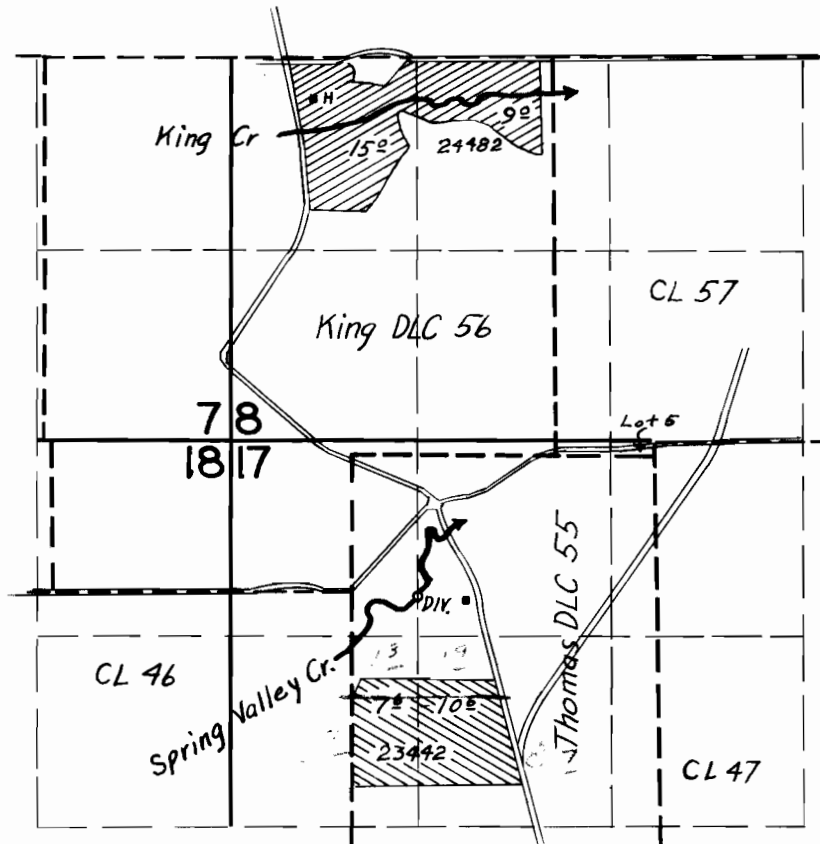

## FINAL PROOF SURVEY

UNDER

Application No. 23442 18502  
24182 Permit No. 19293

IN NAME OF

Russell D. Hills

C. M. Bitikufer

Surveyed July 16, 1954, by T. Jones