


T.21 S.R. 4 W. W.M.

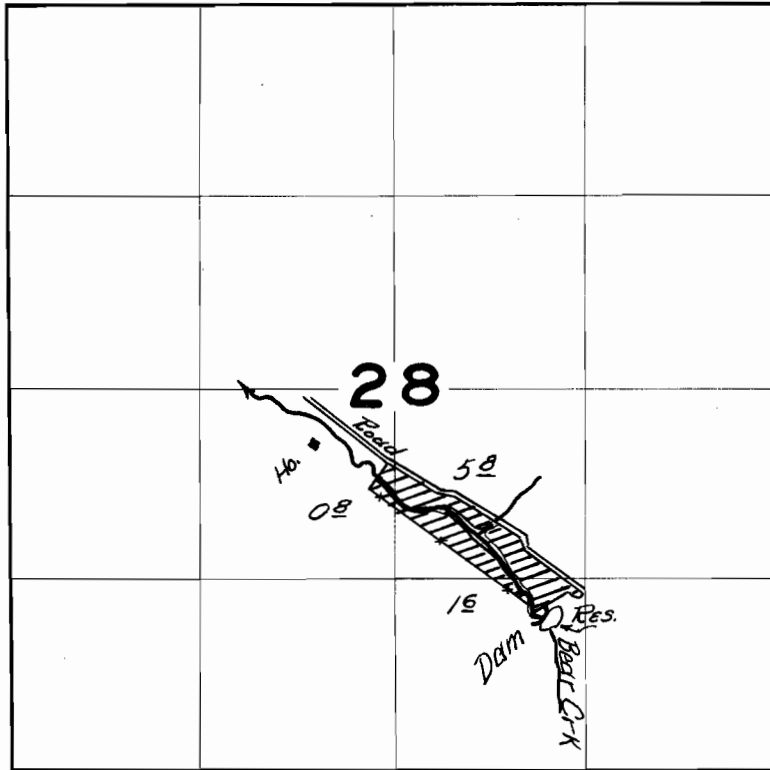

FINAL PROOF SURVEY

UNDER

Application No. 23531 Permit No. 18542

IN NAME OF

Grace E. Goins

Surveyed July 27, 1954, by H. L. Coffman

Db-Hw-32-8
Pantograph