


T.16S.R.7W.WM

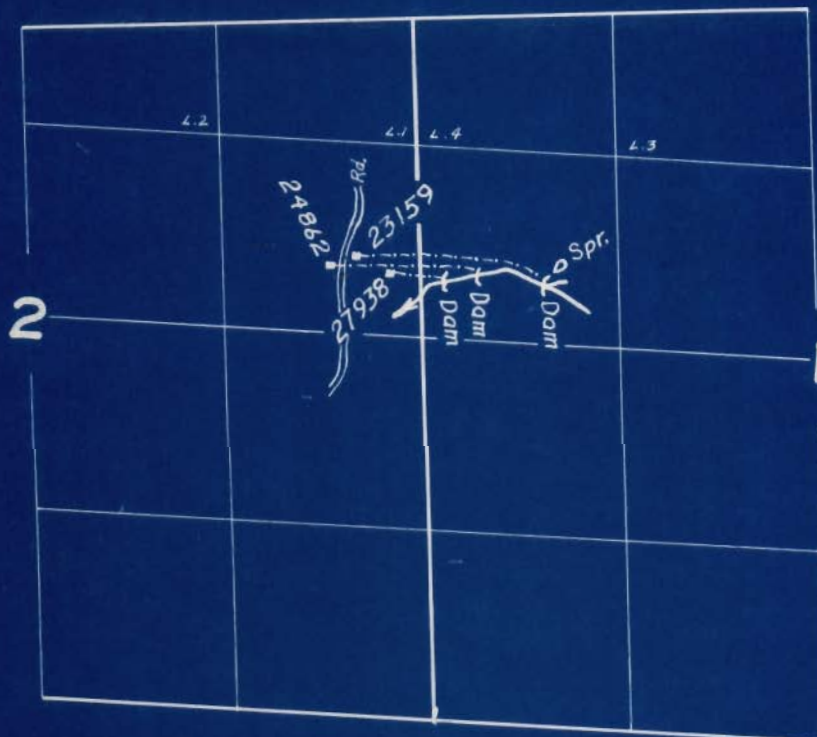

FINAL PROOF SURVEY

27938 22107
24862 19677

Application No. 23159 Permit No. 18243

Dwayne C. Betts

Andrew J. Hamper

Galter B. Robertson

Surveyed April 22, 1954, by D. C. Betts

DBQ-138-186