


, Range 25 E.W.M. .

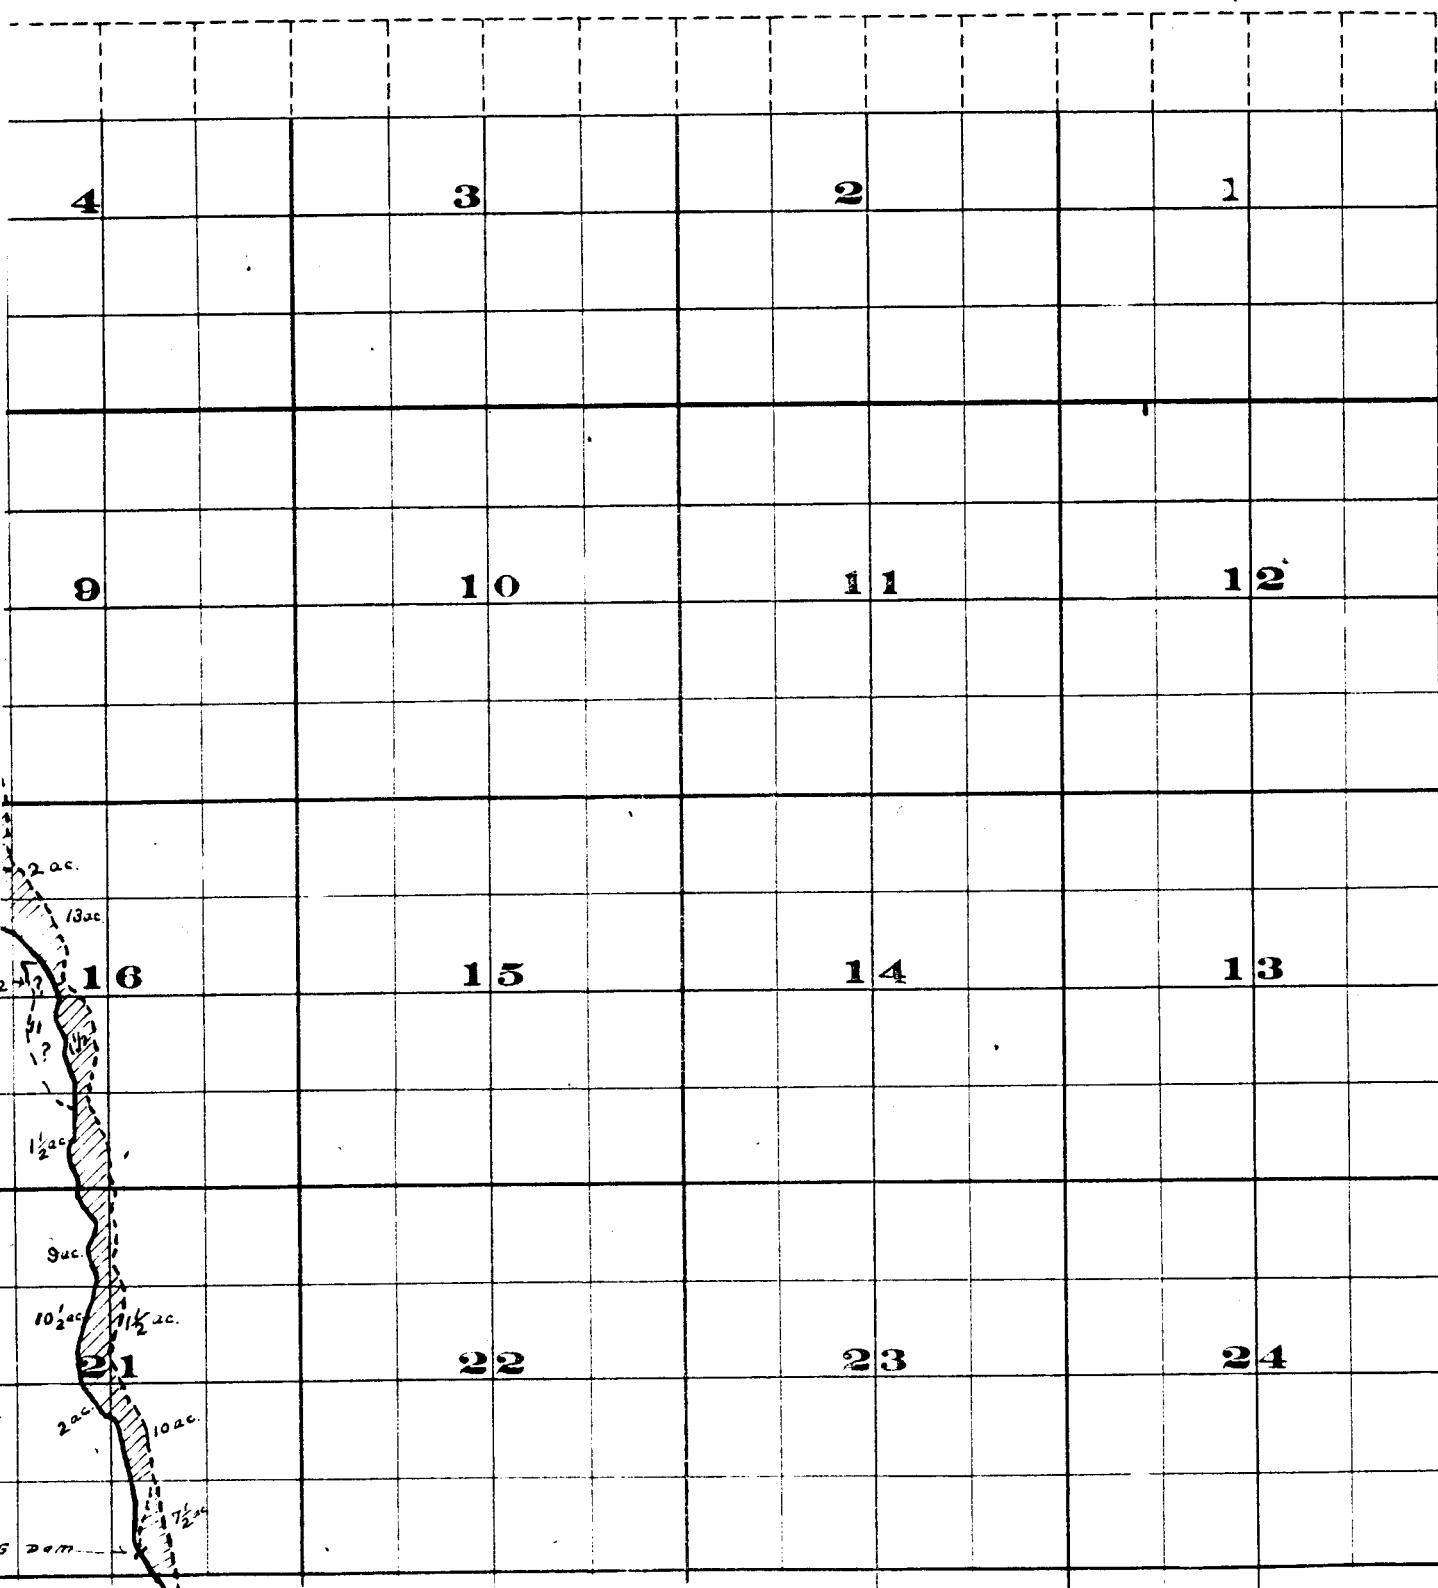

Township 3 S.

