


21003

T.3S.R.12E.W.M

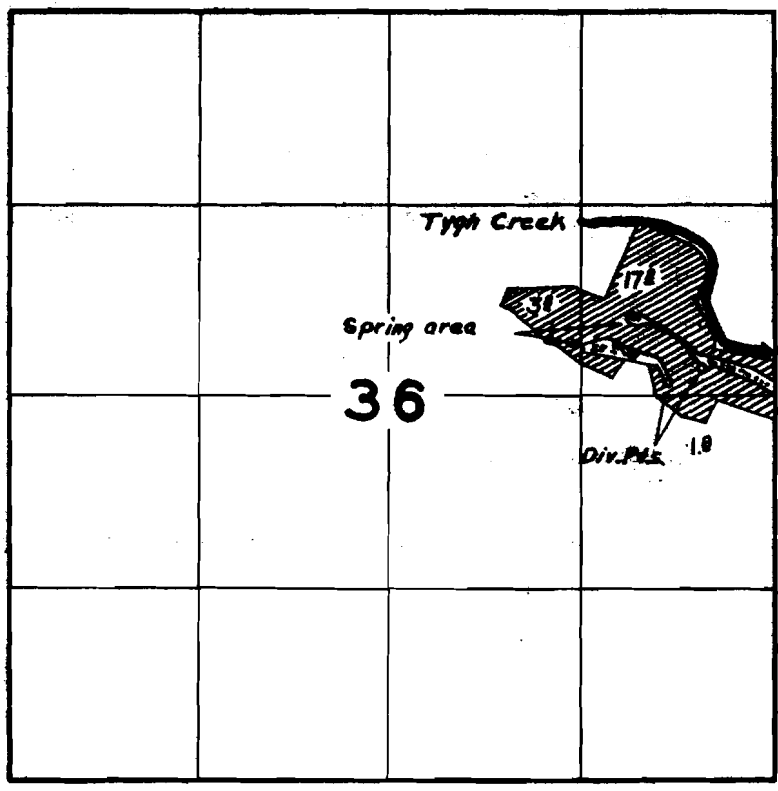

FINAL PROOF SURVEY UNDER

Application No. 25624 Permit No. 20102
IN NAME OF

..... L. D. King

Surveyed June 14 1954, by T. Jones

1950-D

20102