


T.10S.R.2W.WM

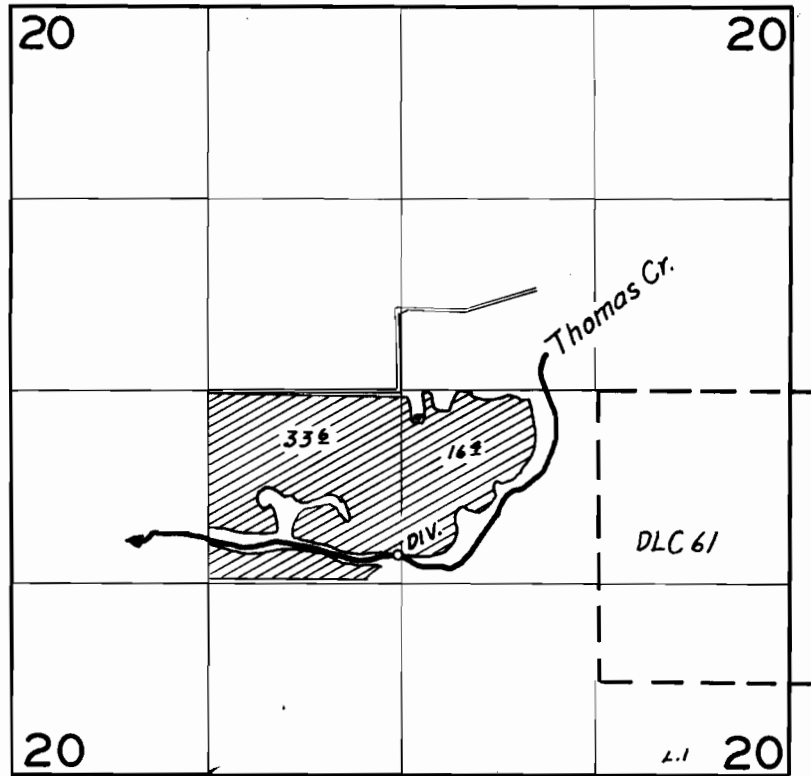

FINAL PROOF SURVEY

UNDER

Application No. 25037... Permit No. 20203...

IN NAME OF

Glenn Densmore

Surveyed July 7, 1954, by H. L. Coffman