


# T.16S.R.4W.WM

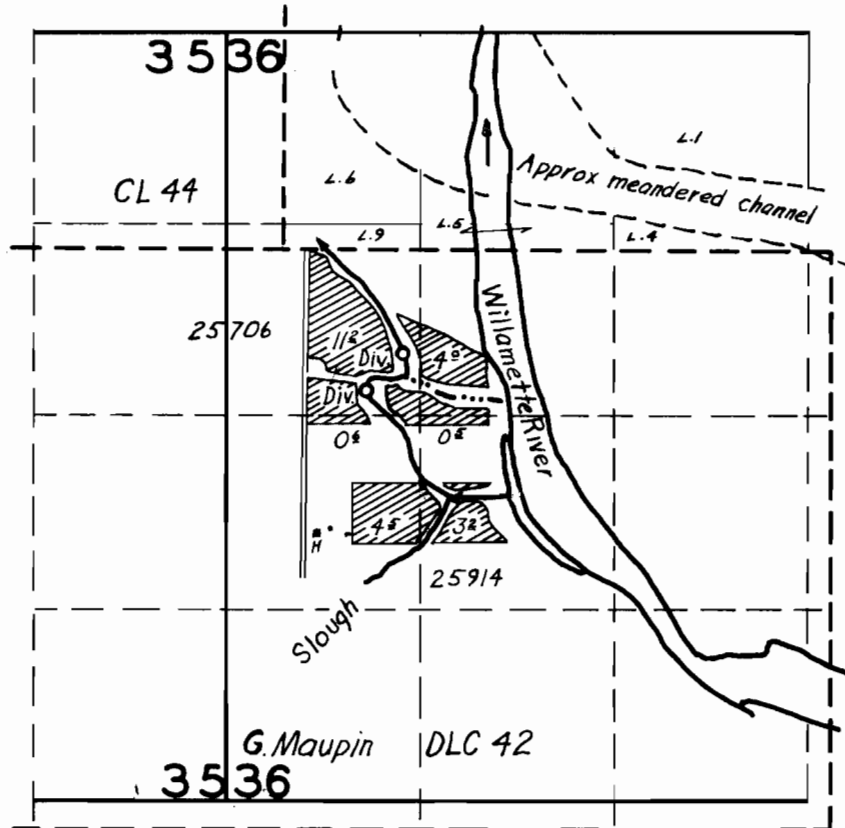

## FINAL PROOF SURVEY

UNDER

Application No. 25914 Permit No. 20327  
25706 20251

IN NAME OF

Signal Mike

Chris S. Christenson

Surveyed April 21 1954, by L. E. C. man