


OFFICE OF STATE ENGINEER  
RECEIVED  
JUN 27 1916  
SALEM, OREGON.

Application No. 4987  
Permit No. 2976

Sec. 35, Tp. 3 N. R. 10 E. W. M.

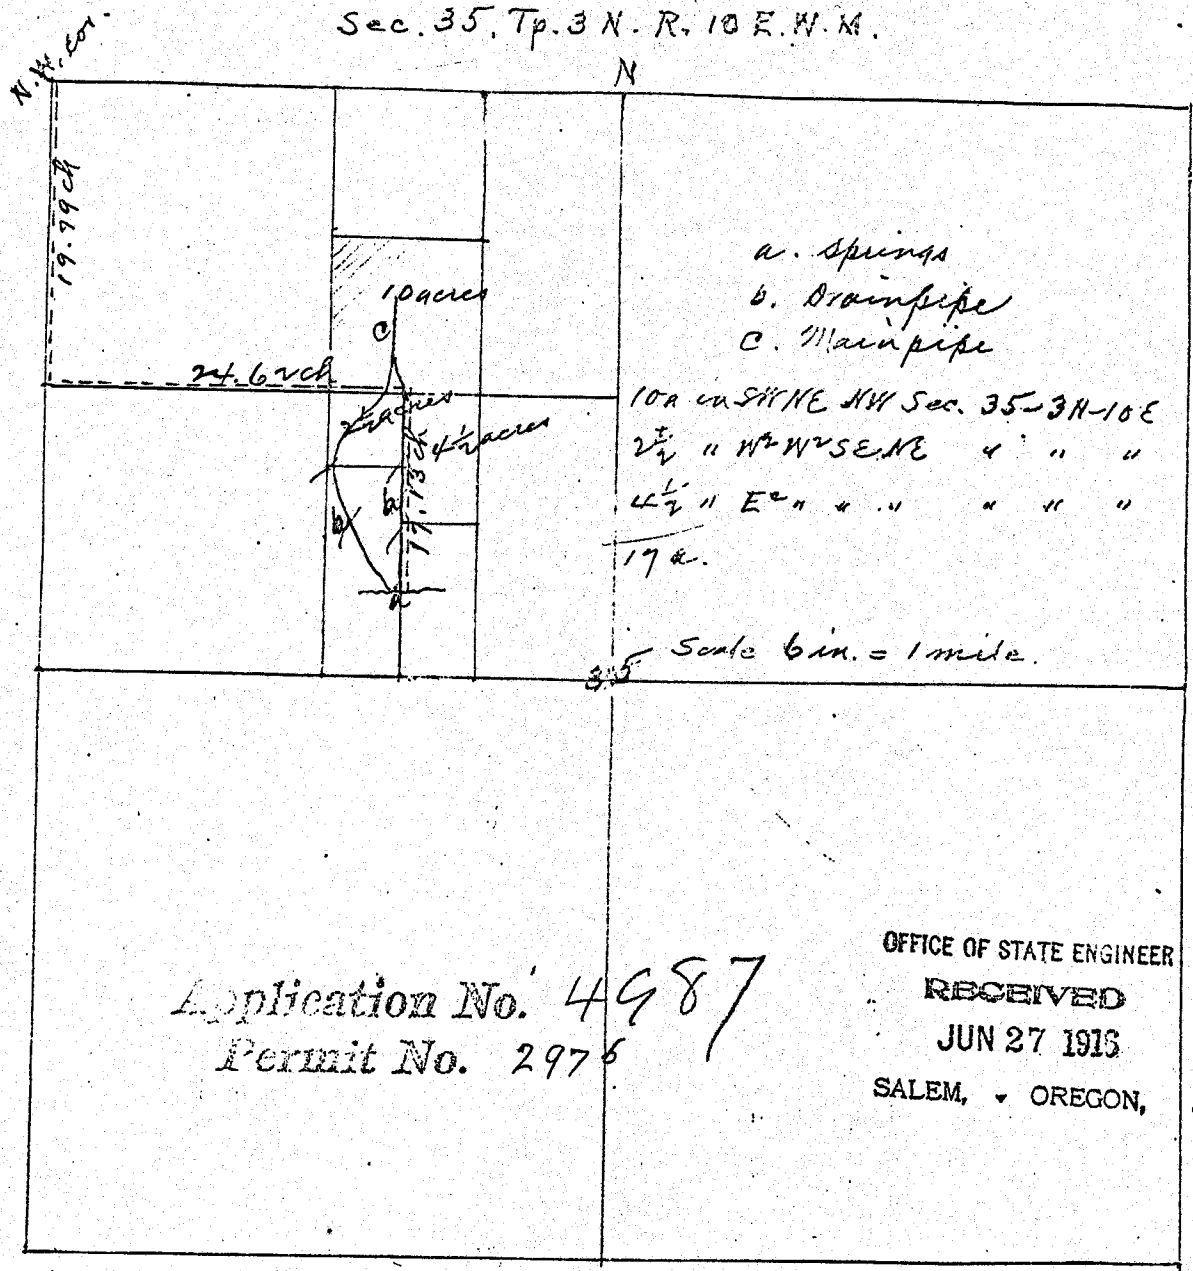

Application No. 4987  
Permit No. 2976

OFFICE OF STATE ENGINEER  
RECEIVED  
JUN 27 1916  
SALEM, OREGON.

CERTIFICATE OF SURVEYOR.

I, A. W. Onthank, of Hood River, Oregon, do hereby certify that this map was made from notes taken during an actual survey made under my supervision on the 19th day of June, 1916, and that it correctly represents the works described in the accompanying application, together with the location of ditches and drains in the immediate vicinity, and has written thereon the area in <sup>each</sup> smallest legal subdivisions which it is proposed to irrigate.

A. W. Onthank