


T.9S.R.3 W.W.M.

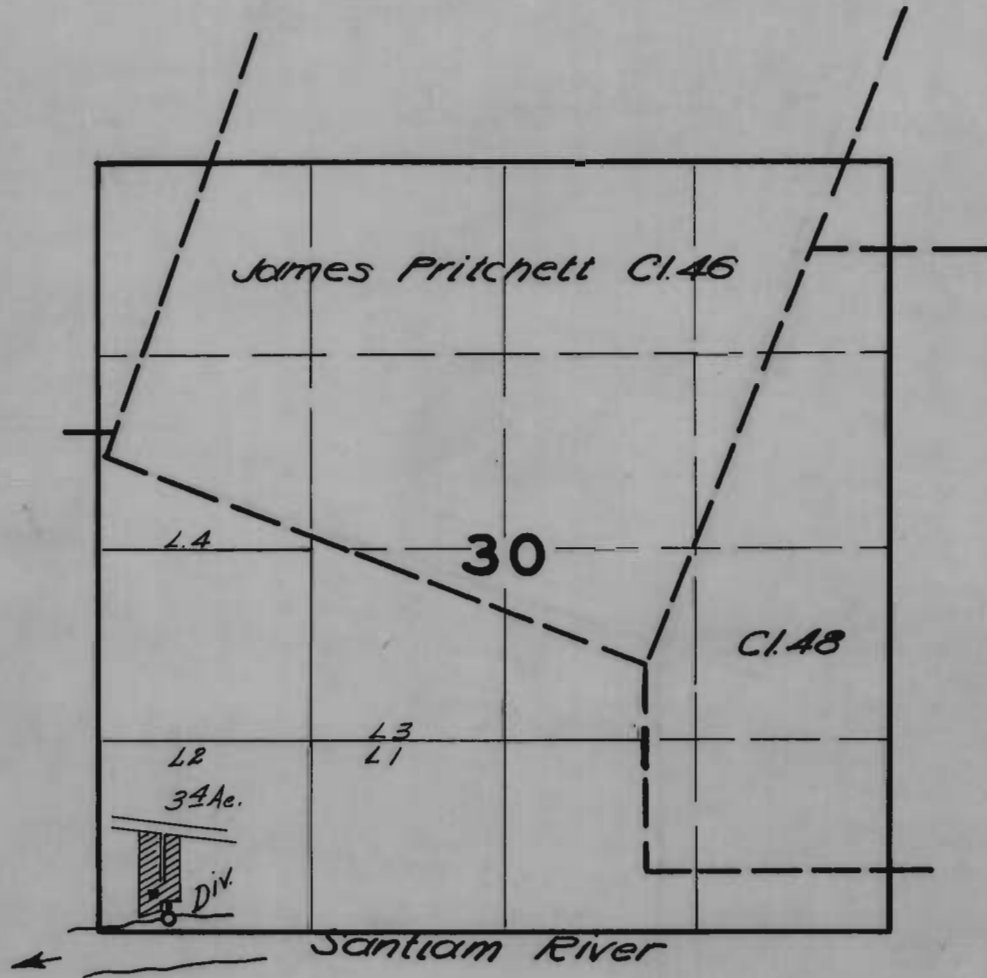

FINAL PROOF SURVEY

UNDER

Application No. 26465 Permit No. 20747

IN NAME OF

Bert C. Morris

Surveyed June 5, 1954, by H. L. Coffman