


T.28S. R.46 E.W.M.

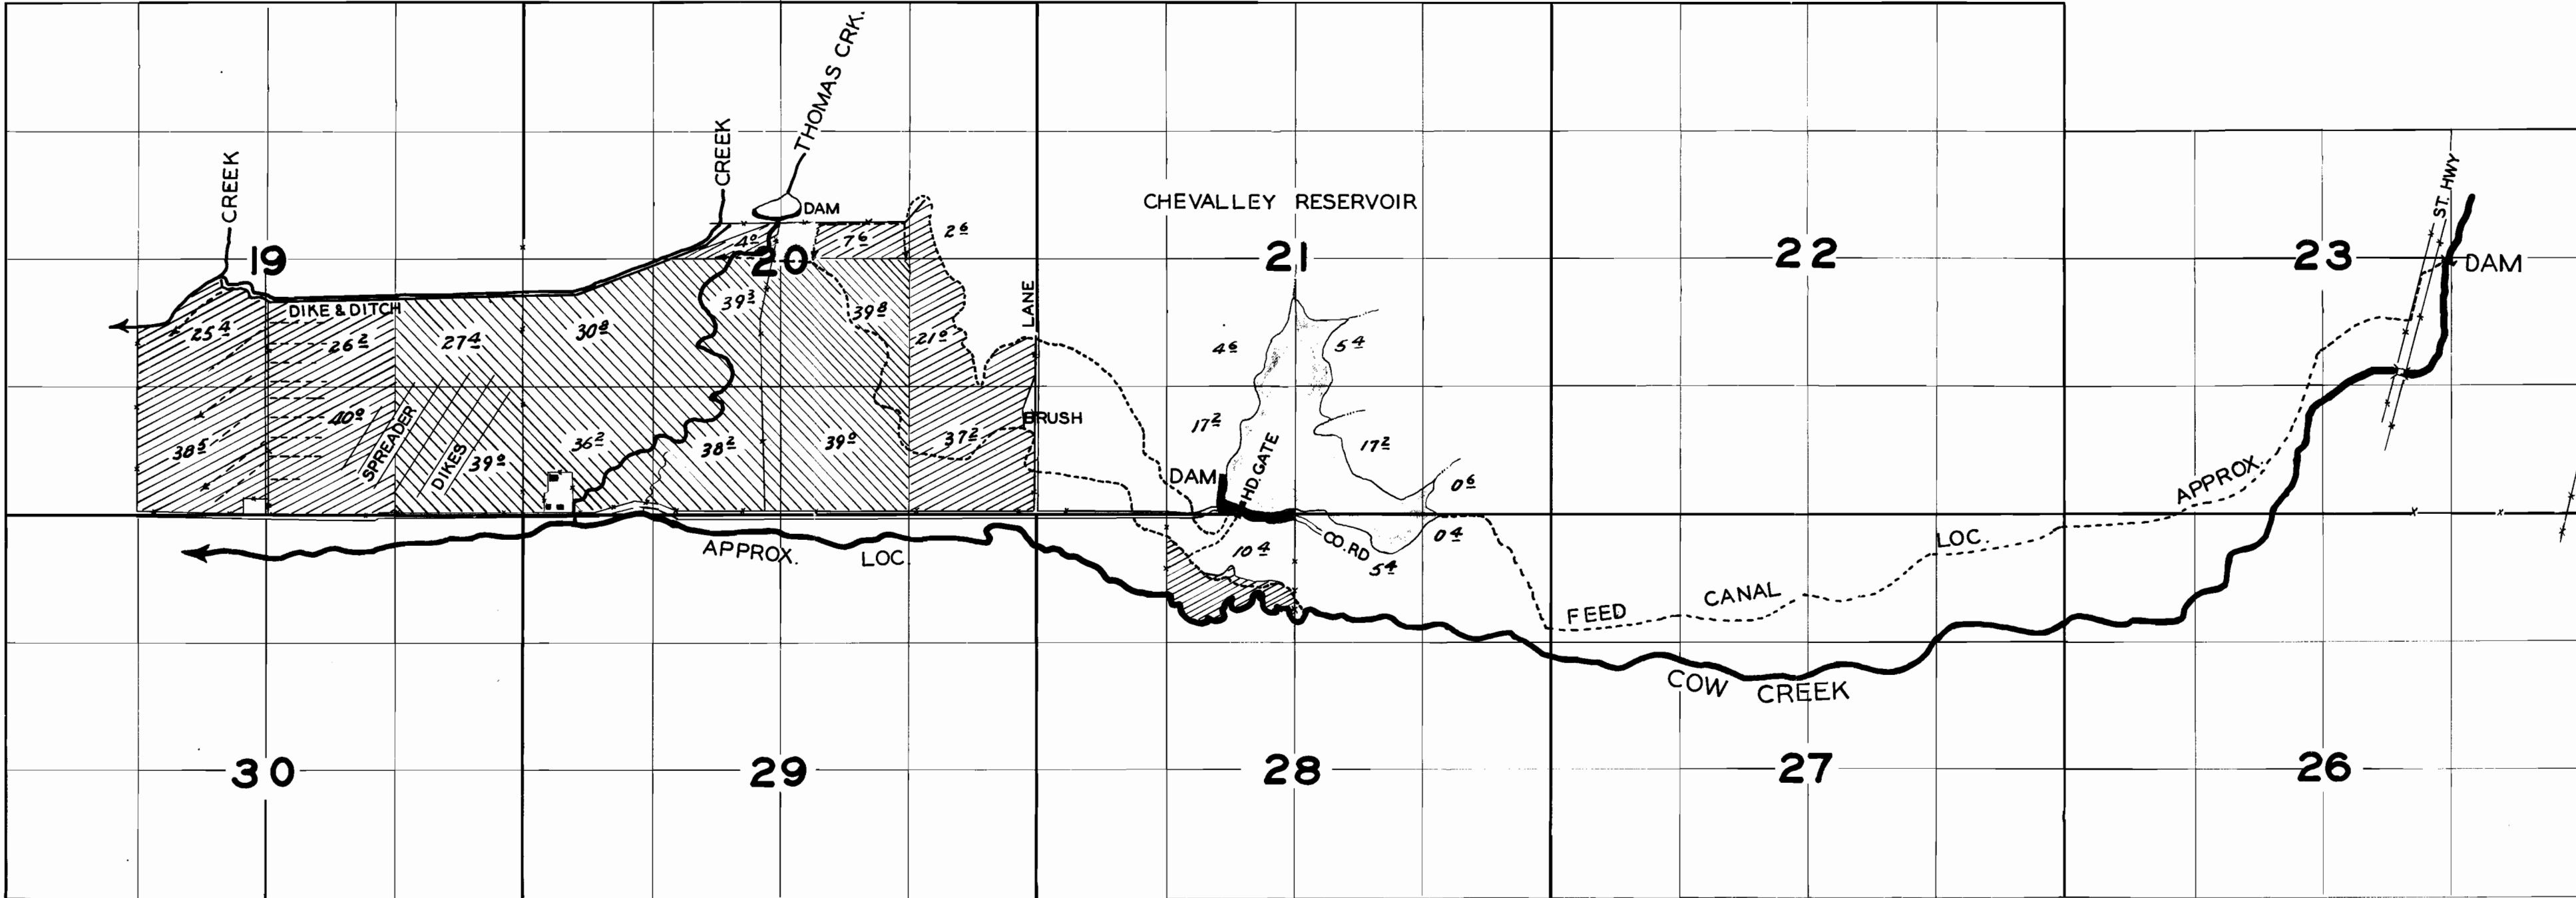

FINAL PROOF SURVEY

C.E. ODOM

APPLICATION NO. R_4996 & 4997

PERMIT NO. R_ 367 & 3008

SURVEYED MARCH 27-28 1955 BY *H.L. Coffman*

1955 0