


T.28S. R.46 E.W.M.

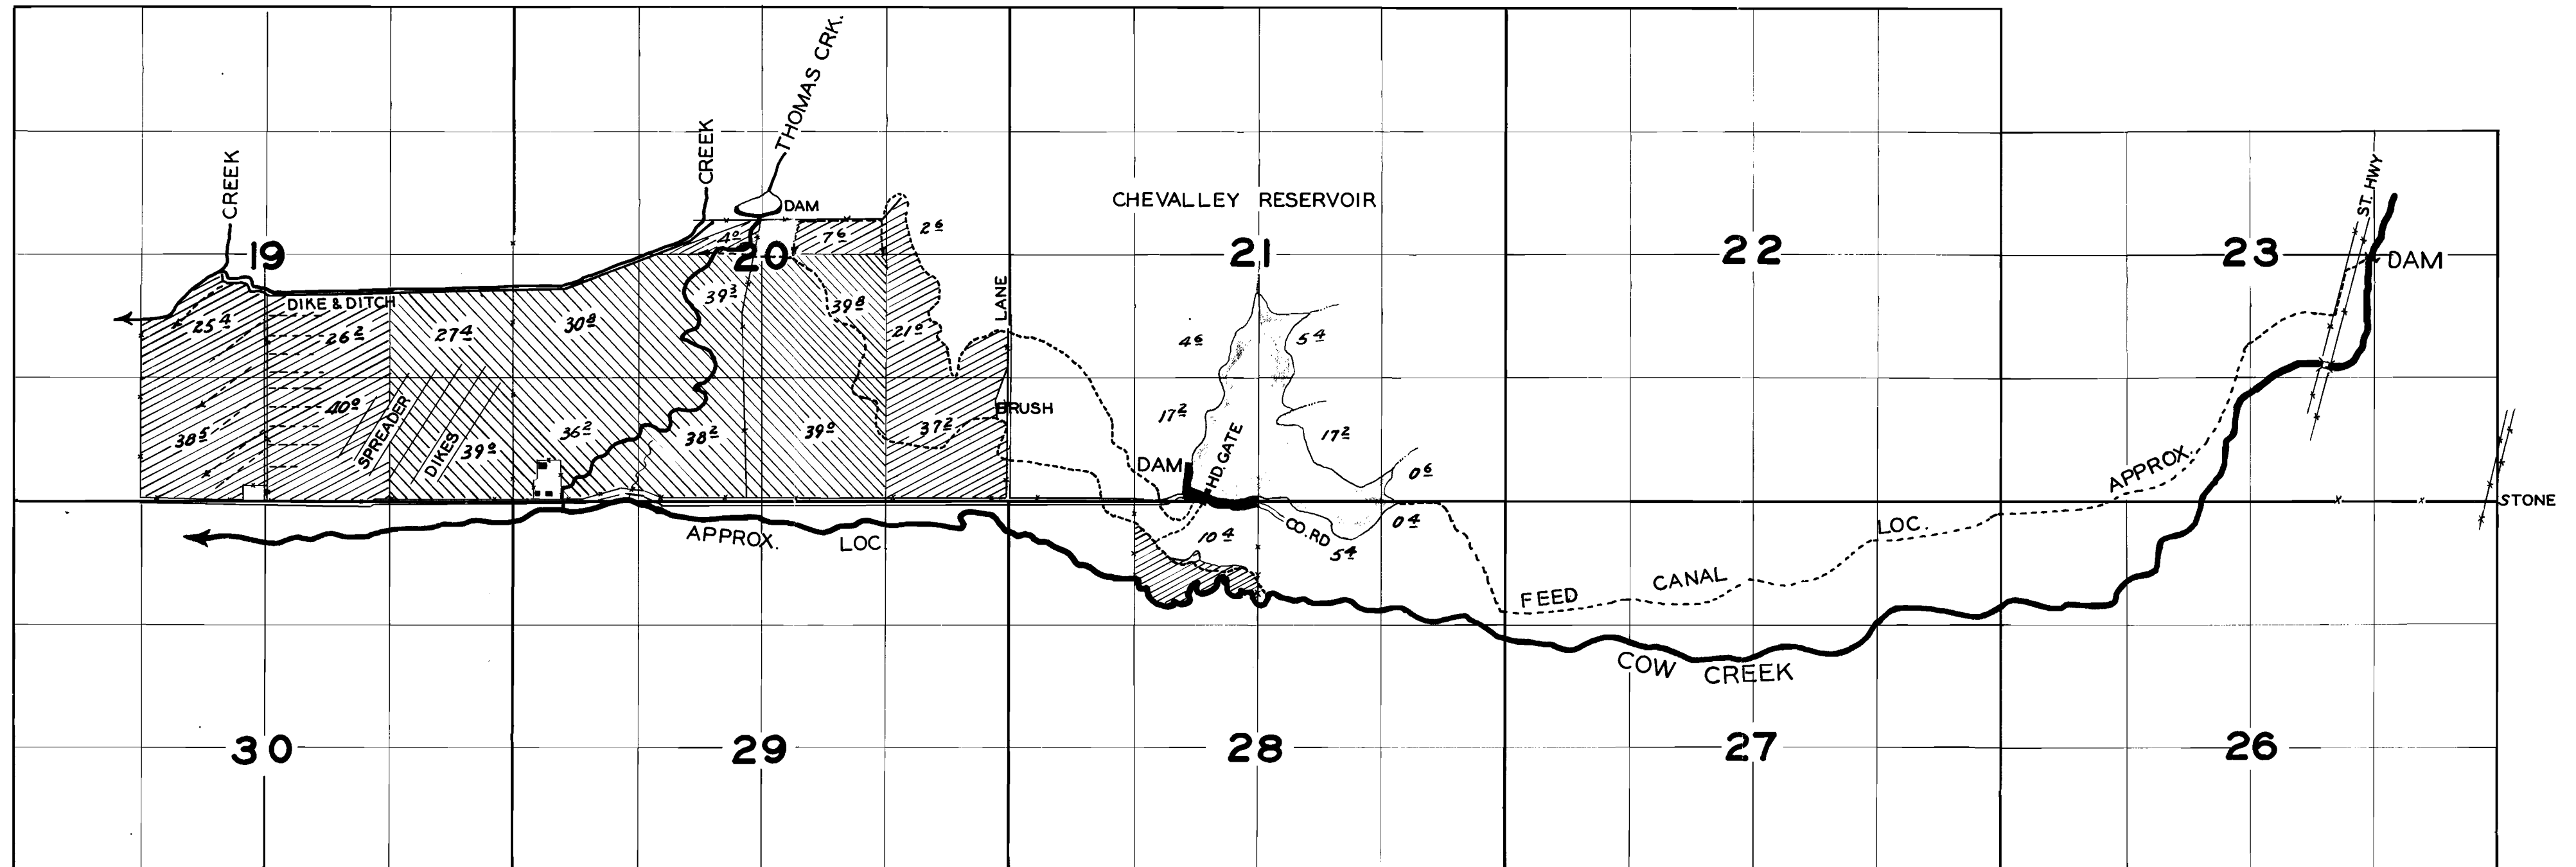

FINAL PROOF SURVEY

C. E. ODOM

APPLICATION NO. R. 4996 & 4997

PERMIT NO. R. 367 & 3008

SURVEYED MARCH 27, 28 1955 BY *H. L. Coffman*

1955 D