


TOWNSHIP 15 S, RANGE 7 W, W. M.

North

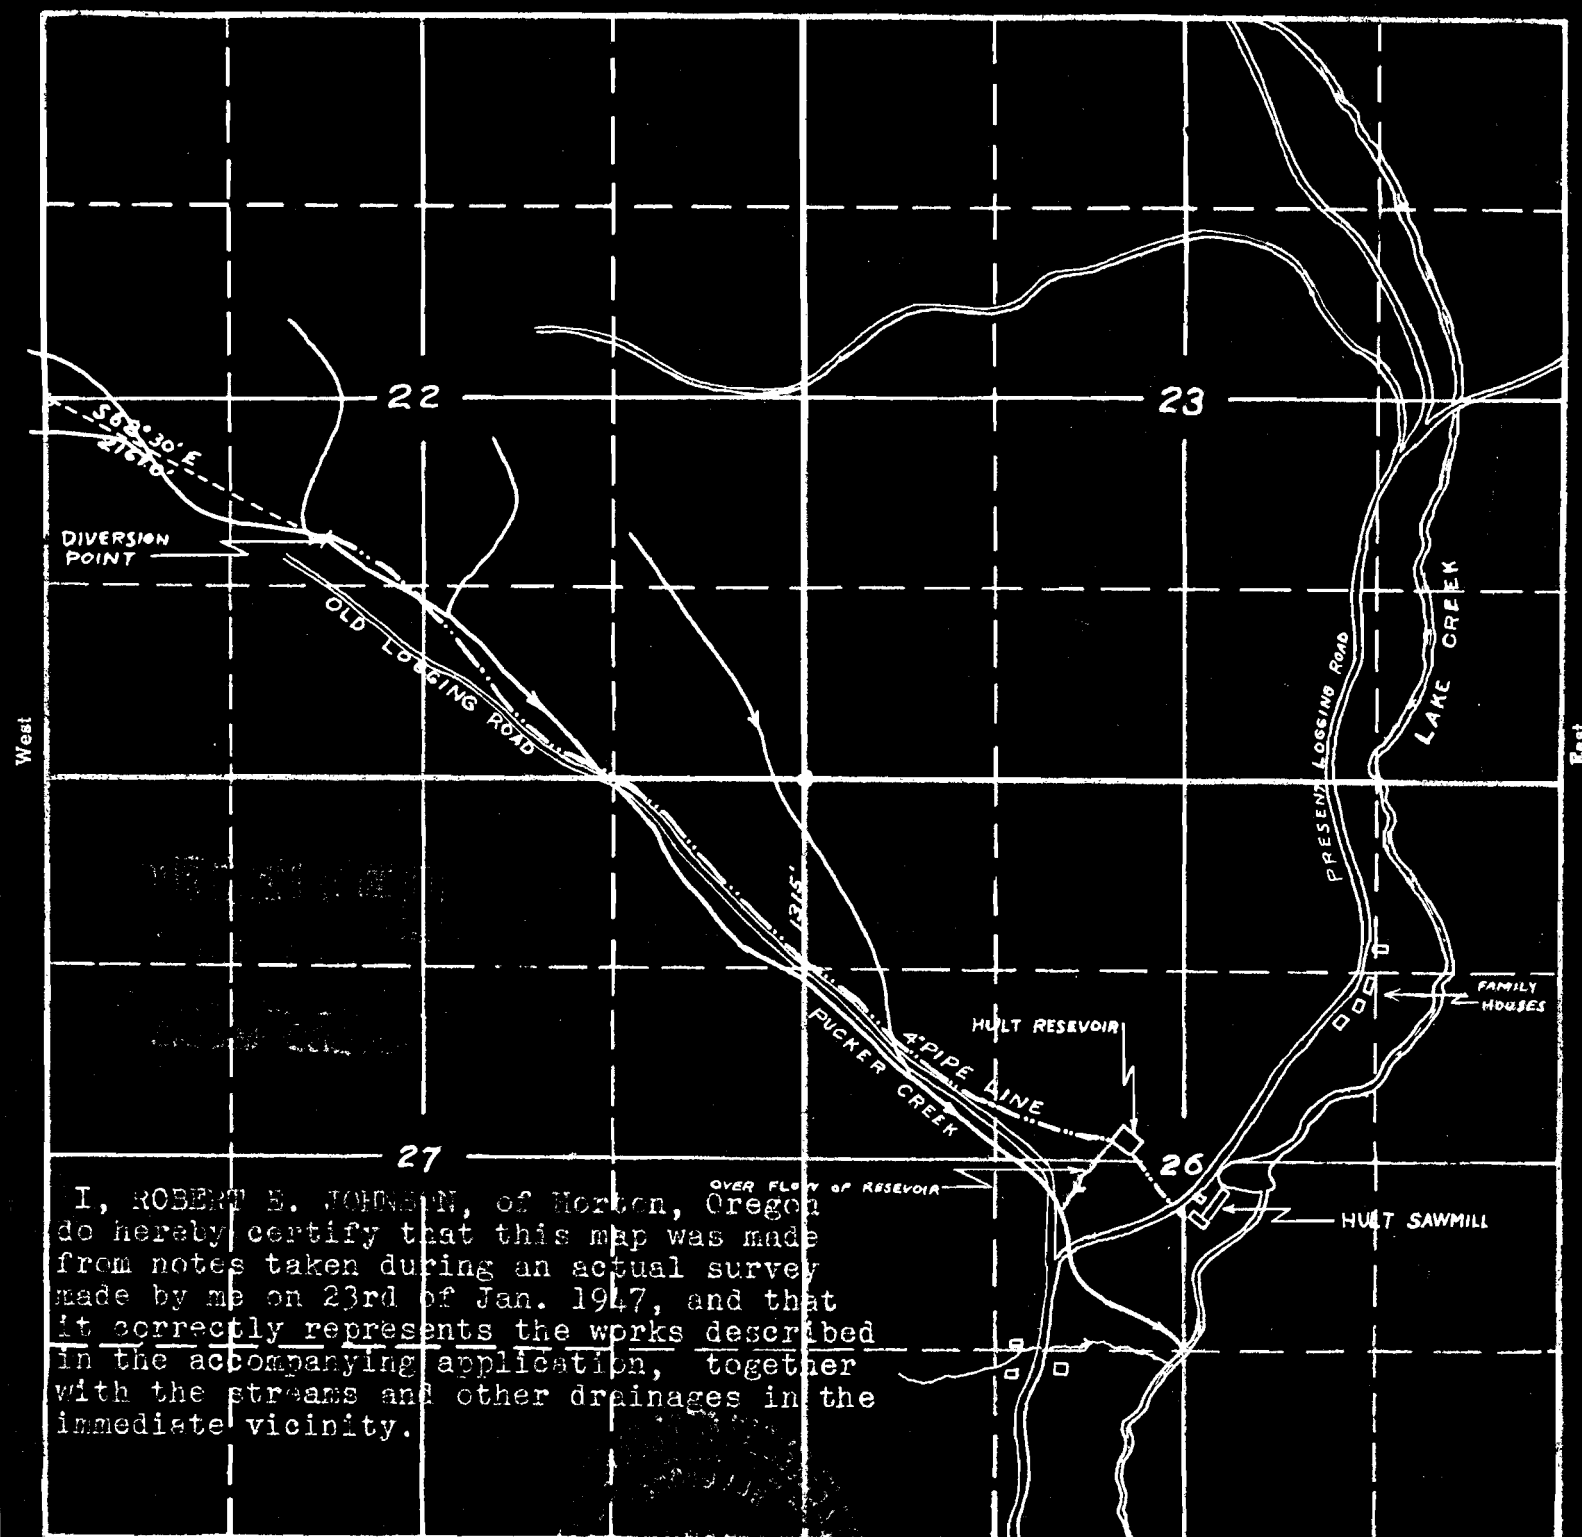


I, ROBERT E. JOHNSON, of Norton, Oregon do hereby certify that this map was made from notes taken during an actual survey made by me on 23rd of Jan. 1947, and that it correctly represents the works described in the accompanying application, together with the streams and other drainages in the immediate vicinity.

SCALE 4 INCHES=1 MILE

HULT LUMBER COMPANY

 APPLICATION No. R-22345
 22346
 PERMIT No. 877
 17013

T. 15 S. R. 7 W. WM

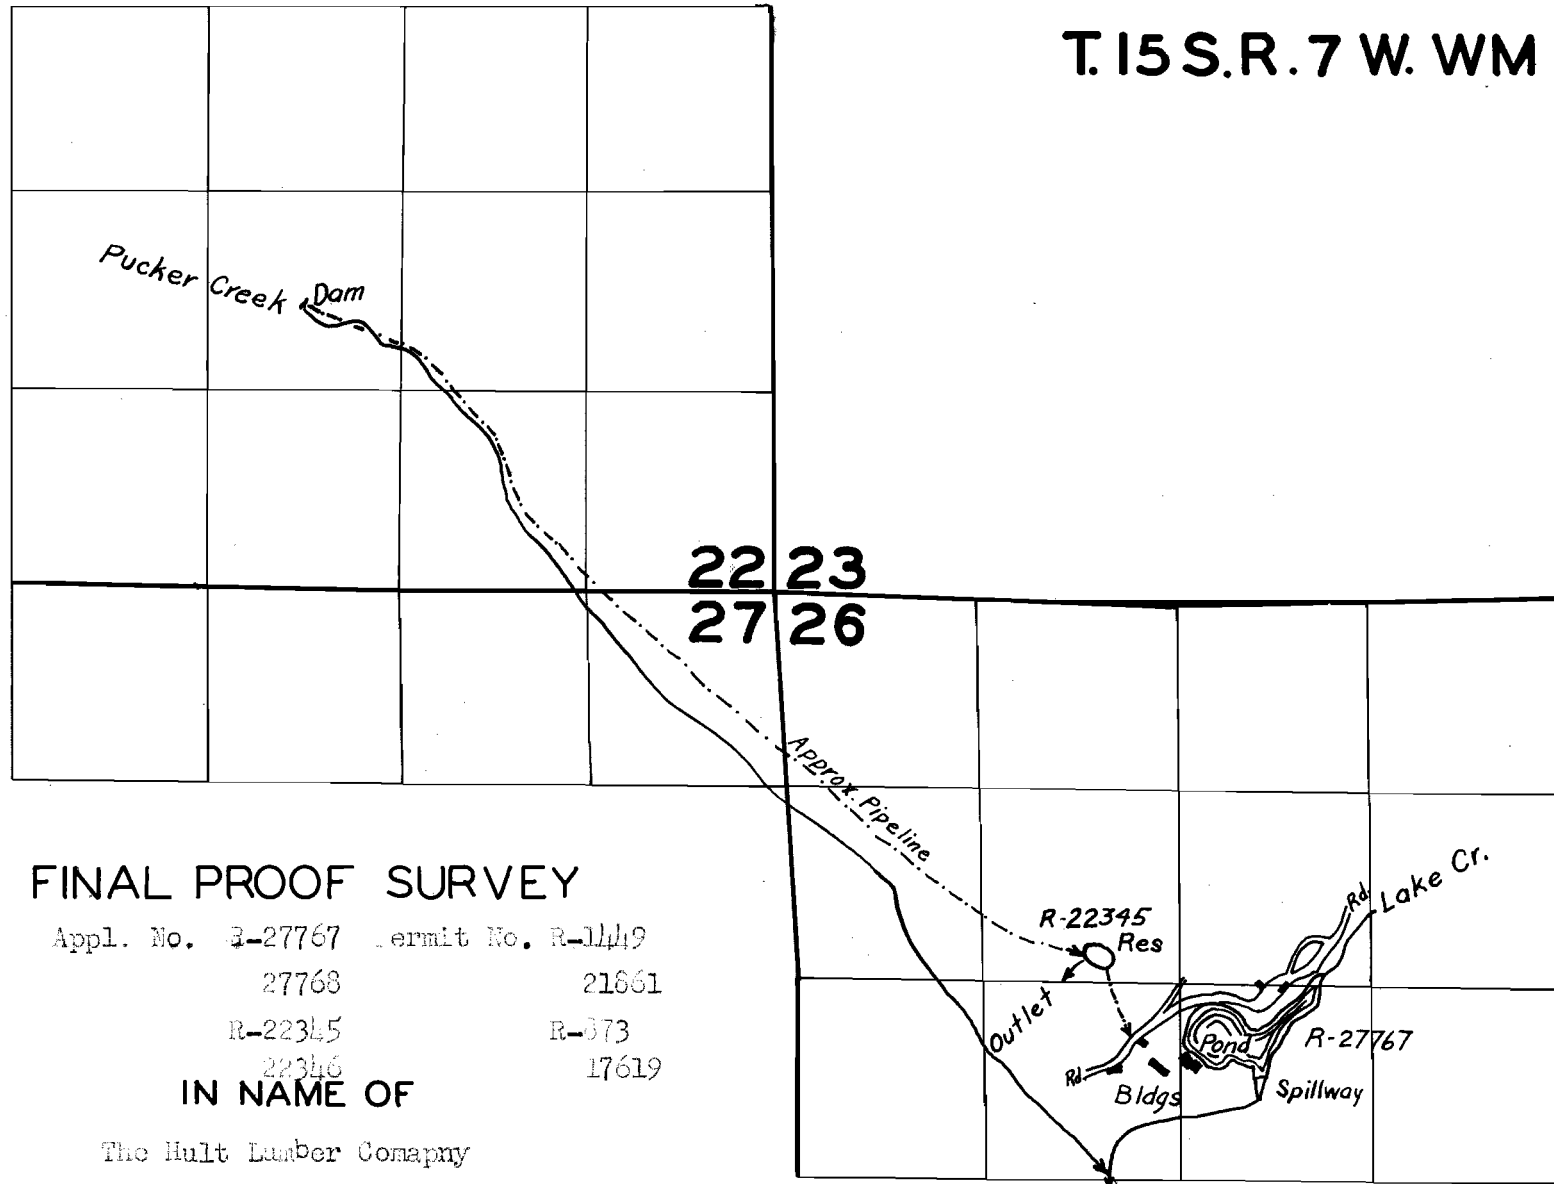

FINAL PROOF SURVEY

Appl. No. B-27767 Permit No. R-11449
27768 21861
R-22345 R-873
22346 17619

IN NAME OF

The Hult Lumber Company

Surveyed by E. L. Coffman April 20, 1954

DD-13H-184

DD-9H-31

DD-13H-184
DD-9H-31