


# T.6S.R.4W.WM

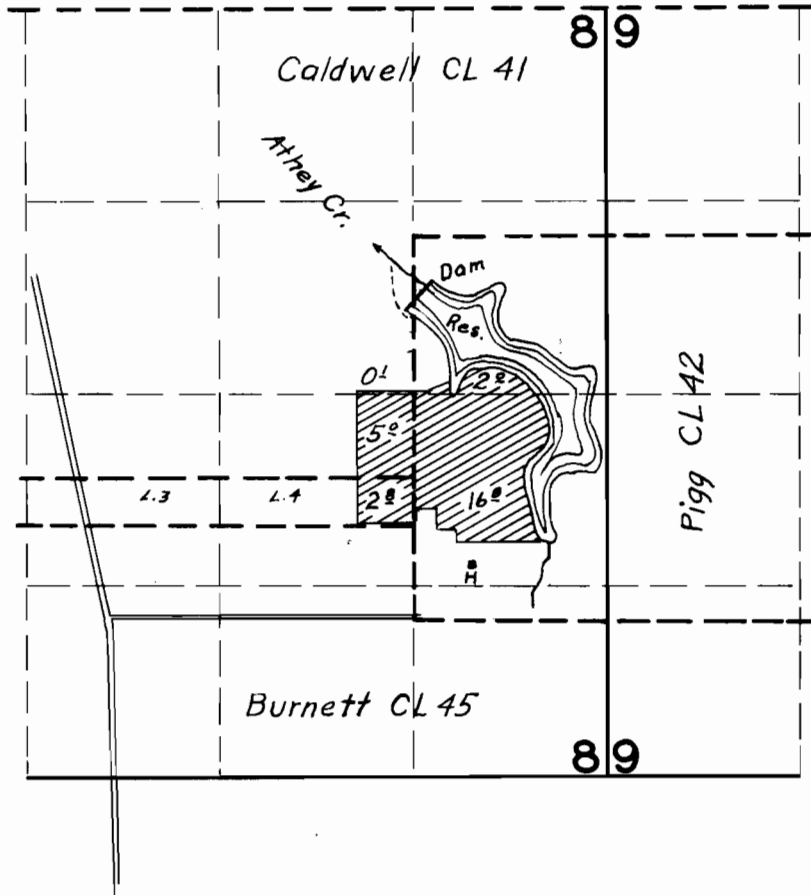

## FINAL PROOF SURVEY

UNDER  
23902

19073

Application No. R-23901 Permit No. R-989...

IN NAME OF

S. Leslie Stewart

Surveyed July 8, 1954, by T. Jones