


T.12S.R.1E.W.M.

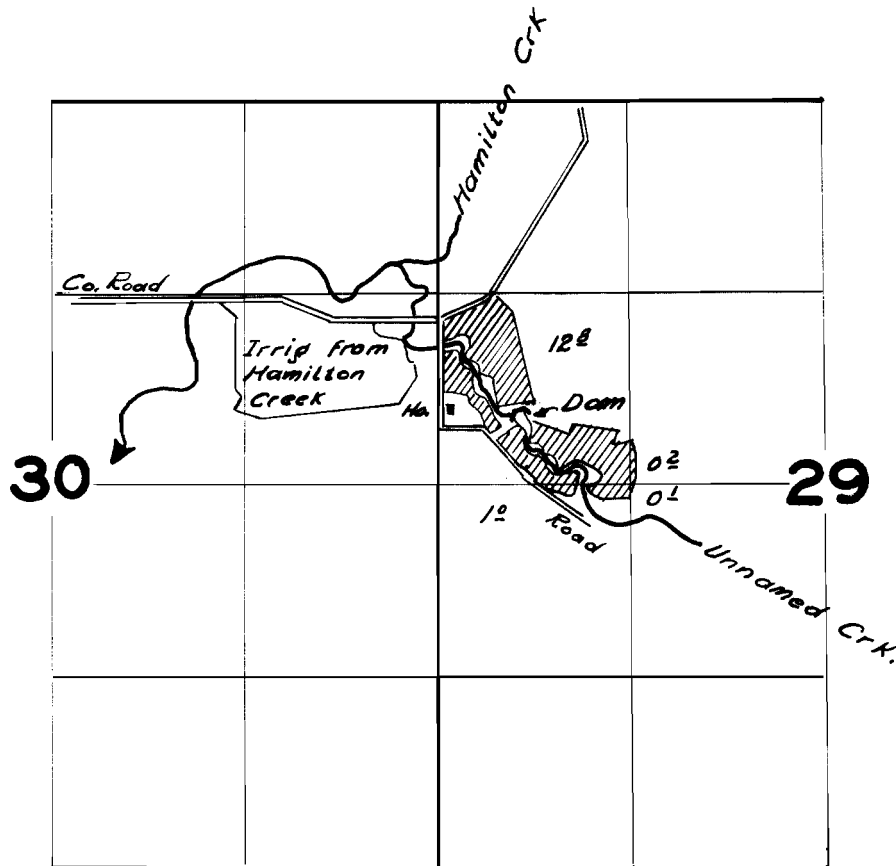

FINAL PROOF SURVEY

UNDER

R-25083

R-1095

Application No. 24533 Permit No. 19922.

IN NAME OF

Donald C. and Leona B. Piper

Surveyed Aug. 5, 1954, by H. L. Coffman

DEK-5-118

Pantograph