


T. 5 S., R. 1 W., W.M.

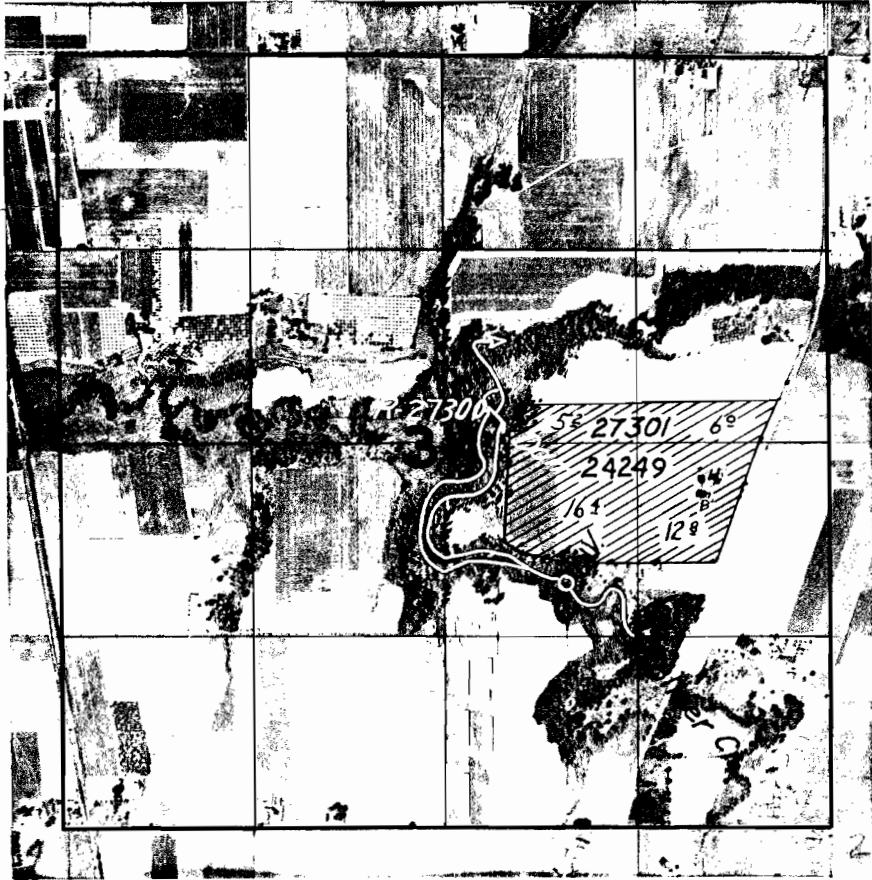

FINAL PROOF SURVEY

UNDER

24249

19210

Application No. 27301 Permit No. 24471
IN NAME OF

..... J. W. Hamner

Surveyed May 7, 1941, by Hoffman