


T.5S. R.1W. W.M.

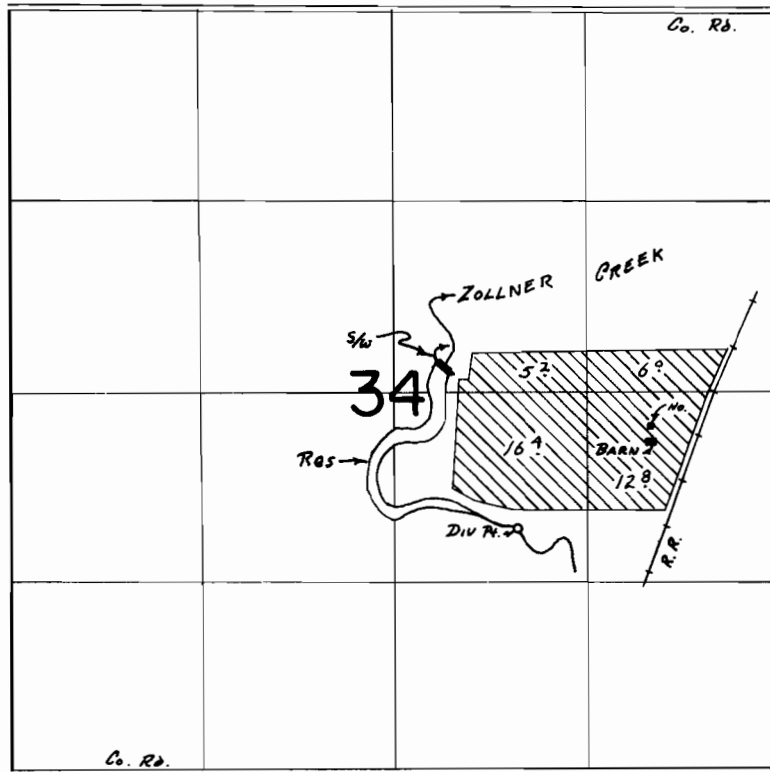


**FINAL PROOF SURVEY**  
UNDER

Application No. 24249 Permit No. 19210  
27301 21471  
IN NAME OF

E. A. HAMMER

Surveyed MAY 7 1954, by H. L. COFFMAN

T. 5 S., R. 1 W., W.M.

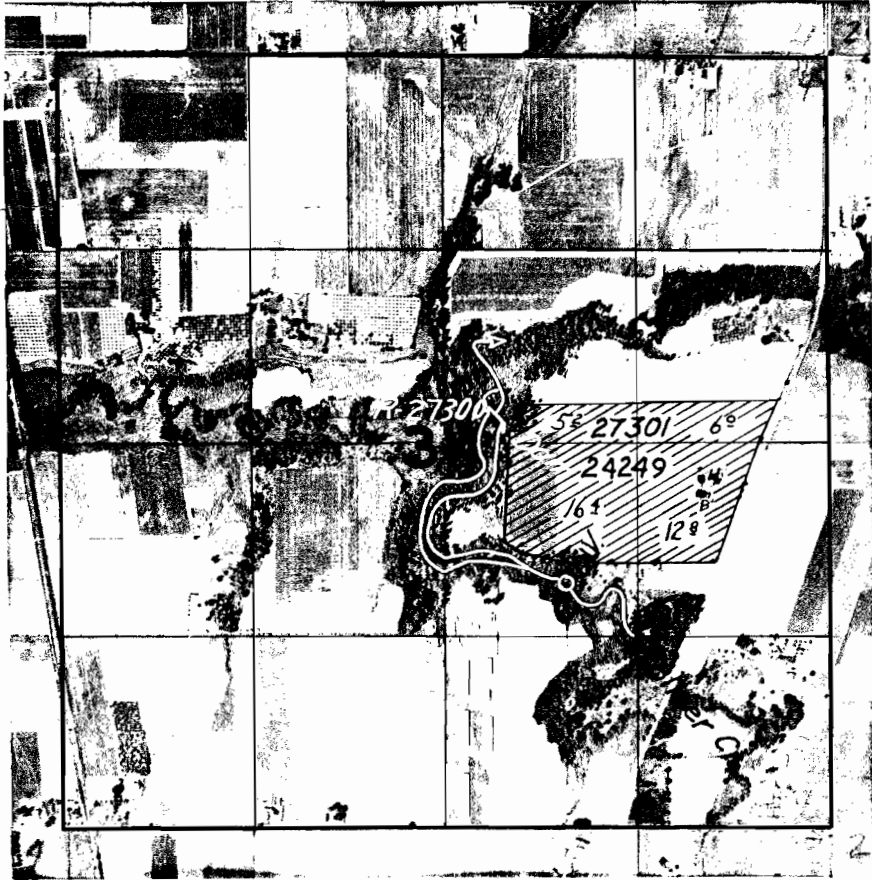

# FINAL PROOF SURVEY

UNDER

24249

19210

Application No. 27301 Permit No. 24471

IN NAME OF

..... J. W. Hamner .....

Surveyed May 7, 1921, by ..... Hoffman .....