


T. 15 S. R. 7 W. WM

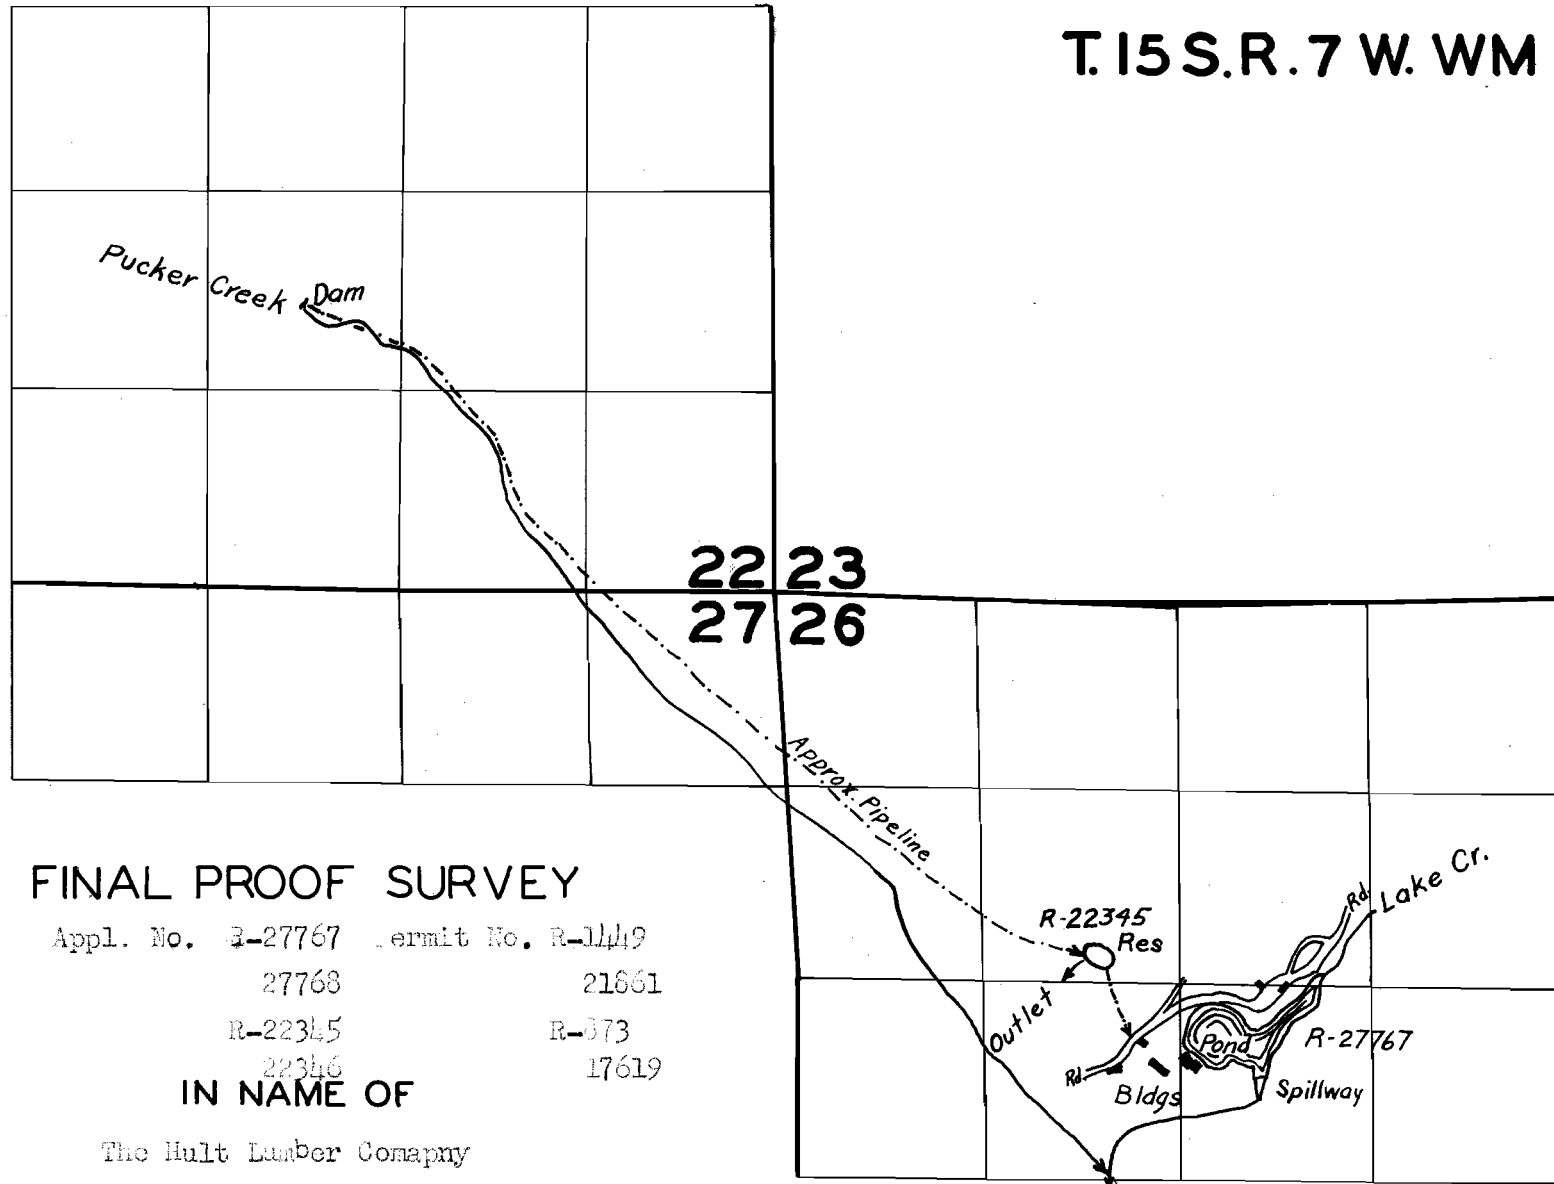

FINAL PROOF SURVEY

Appl. No. B-27767 Permit No. R-11449
27768 21861
R-22345 R-873
22346 17619

IN NAME OF

The Hult Lumber Company

Surveyed by E. L. Coffman April 20, 1954

DD-13H-184

DD-9H-31

DD-13H-184
DD-9H-31