



T.23S.R.5W WM

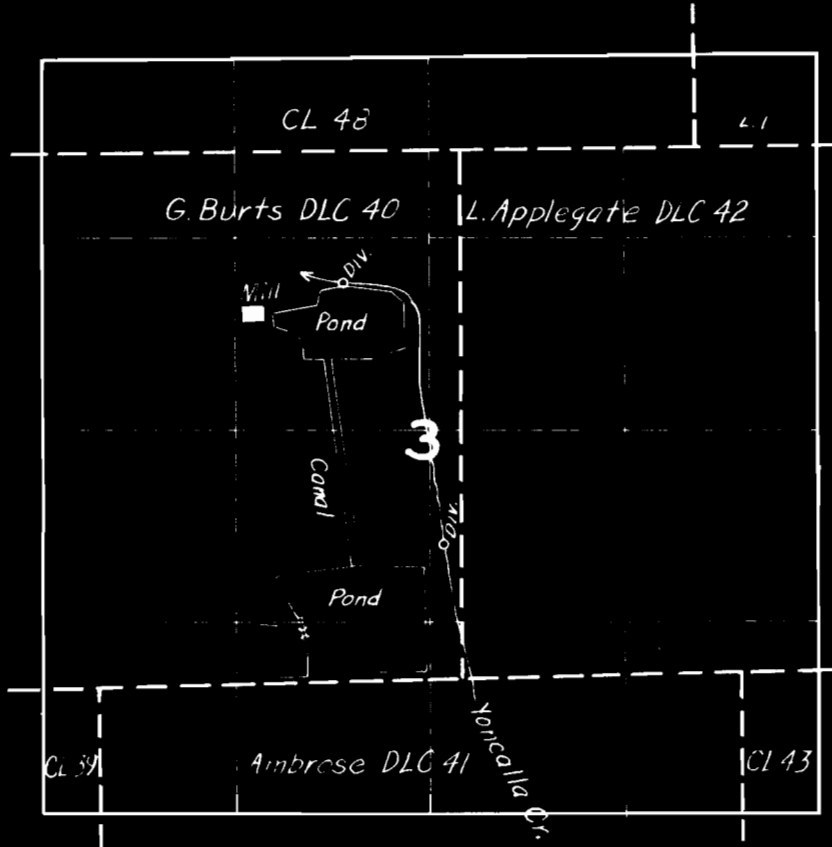

T.23S.R.5W WM

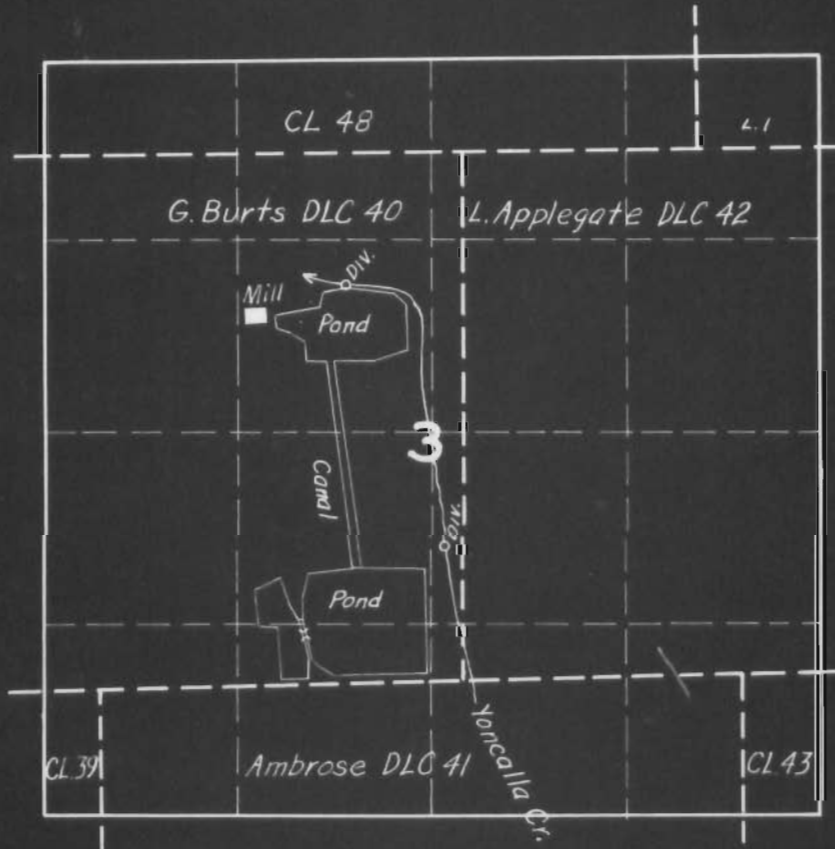

FINAL PROOF SURVEY

Application No. 26822 Permit No. 22681

IN NAME OF

Yoncalla Tr. Co.

Surveyed July 27, 1954, by T. Jones