


T.23S.R.5W WM

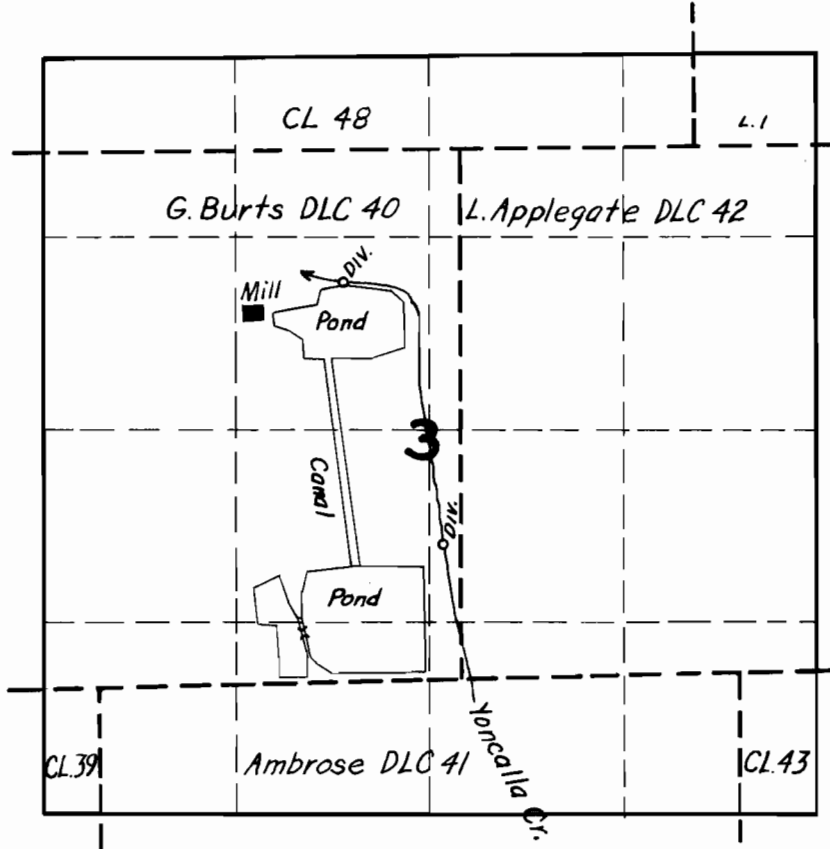

FINAL PROOF SURVEY


Application No. 20022 Permit No. 2005
IN NAME OF

Yoncalla Br. Co.

Surveyed July 27 1954, by L. Danas

1954

T.23S.R.5W WM

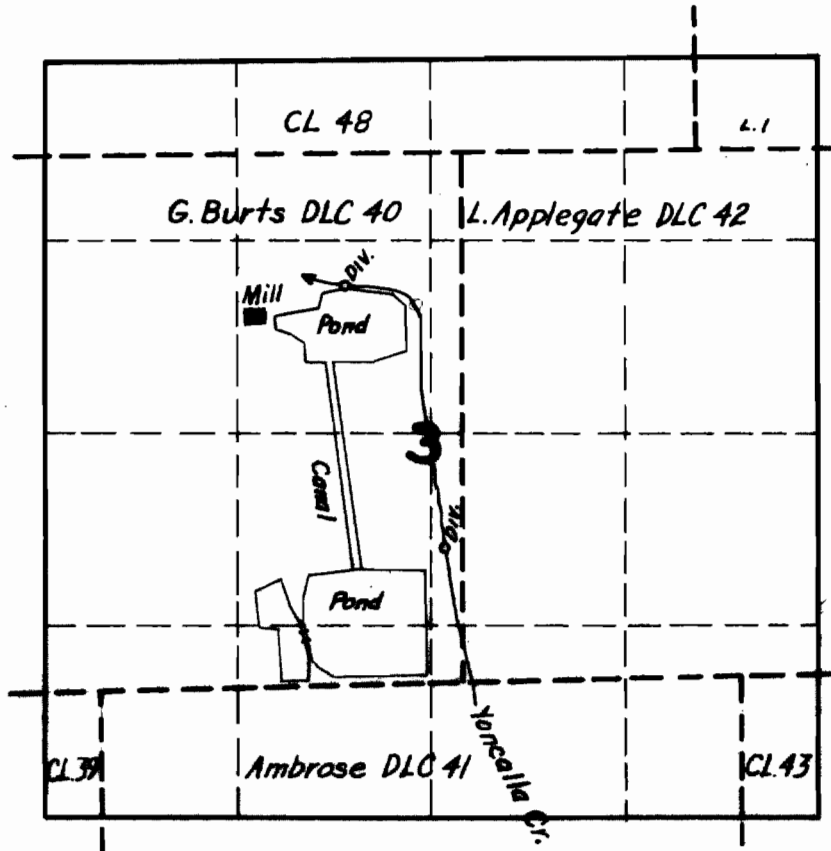

FINAL PROOF SURVEY

R-27188
27205
R-28821

R-1361
21392
R-1579

Application No.28822. Permit No.22681.

IN NAME OF

.....Yoncalla Ibr. Co.

Surveyed July 27, 1954, by T. Jonas

.1954-Z