


T.23S.R.5W WM

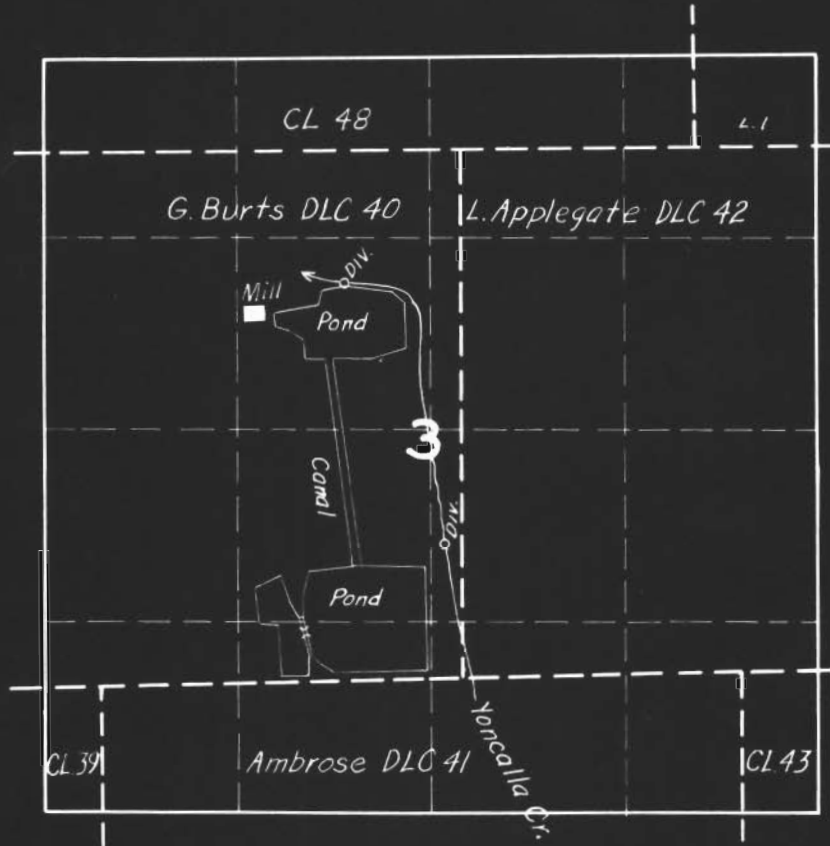

FINAL PROOF SURVEY

Application No. 2322 Permit No. 22601

IN NAME OF

Yoncalla Cr. Co.

Surveyed July 27, 1954, by F. Jones