


T. 17 S. R. 8 W. W. M.

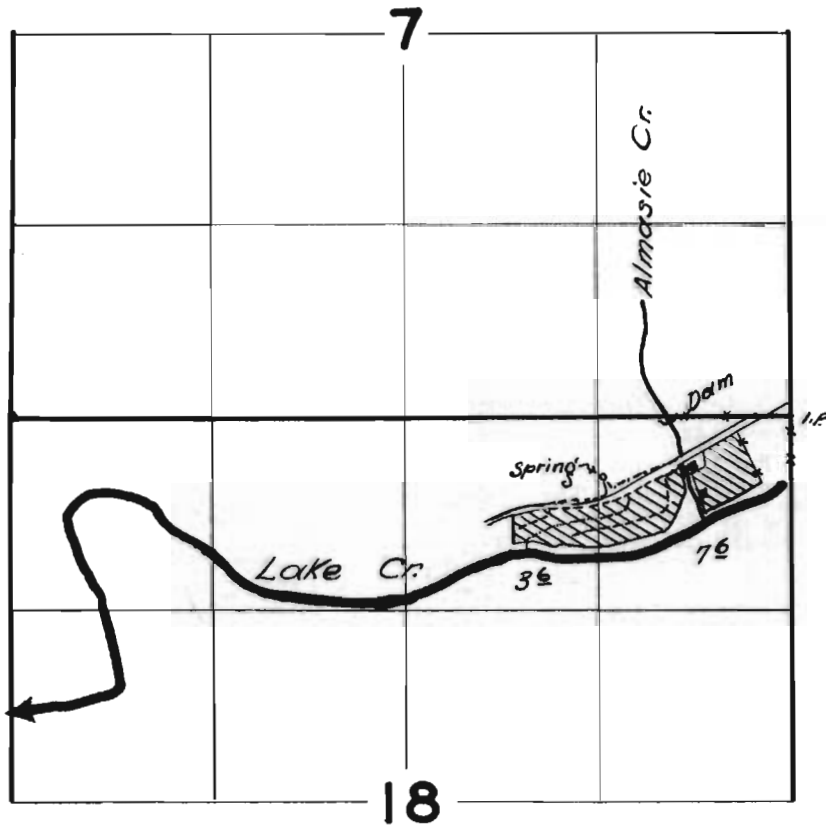

**FINAL PROOF SURVEY**

UNDER

Application No. 16247... Permit No. 12027...  
IN NAME OF

R. A. Carr

Surveyed Aug. 13 1954, by H. L. Goffman