


T. 8 S., R. 4 W., W.M.

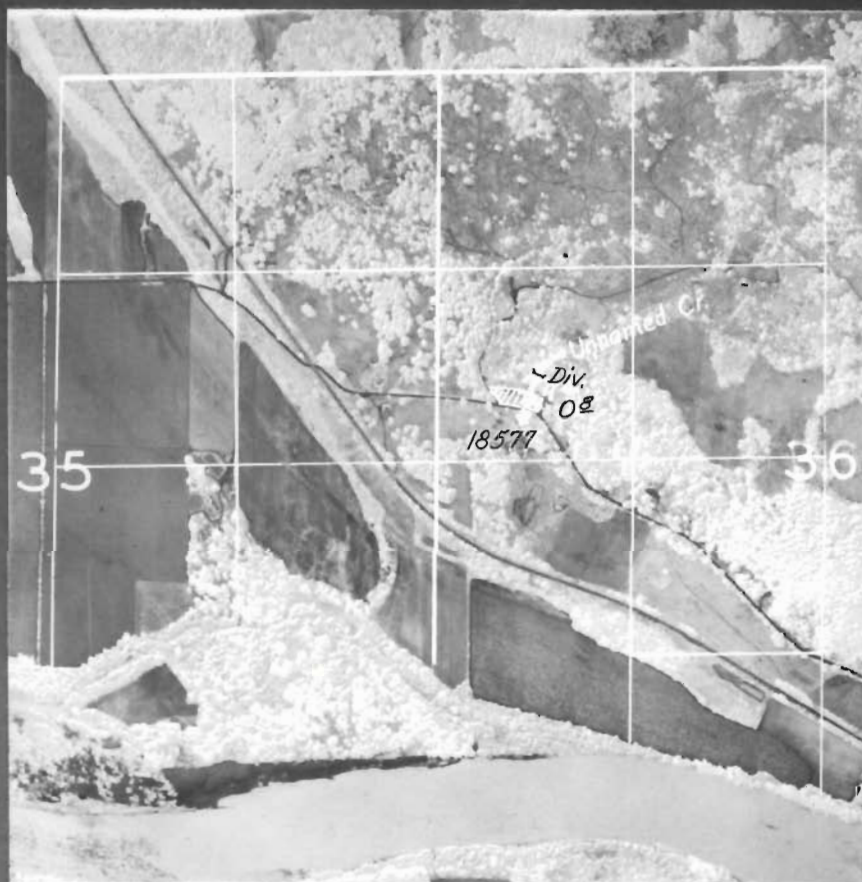

FINAL PROOF SURVEY
UNDER

Application No. ...18577... Permit No. ...14397...
IN NAME OF

.....William Bliven.....

Surveyed April 15 1954., byT. Jones...

DEN 4D 74