


T.29S.R.7W.WM

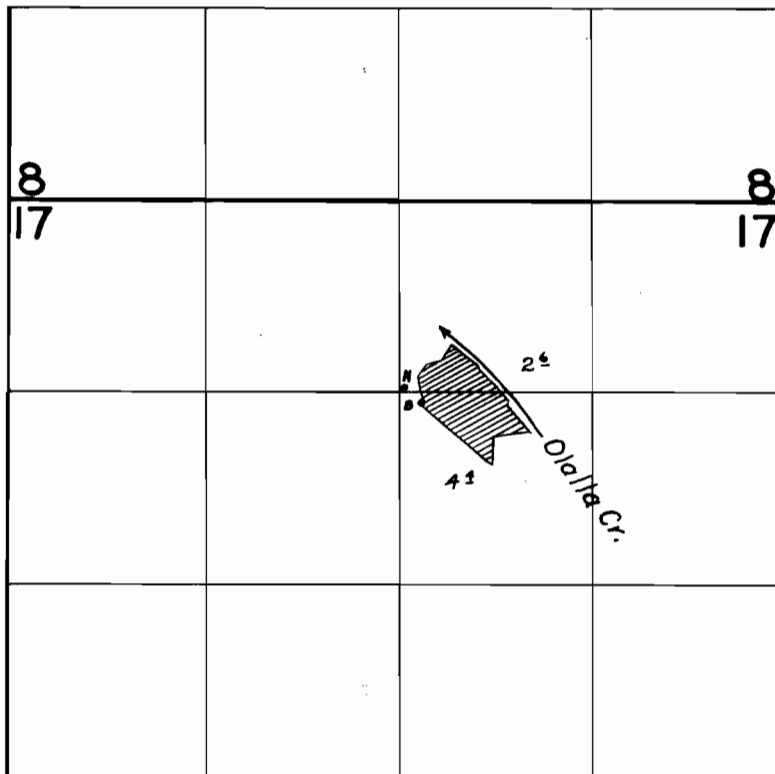

FINAL PROOF SURVEY UNDER

Application No. 21131..... Permit No. 10560.....
IN NAME OF

.....Reginald Johnston.....

Surveyed July 22 19 54 by T. Jones.....