


T.16S.R.6W.WM

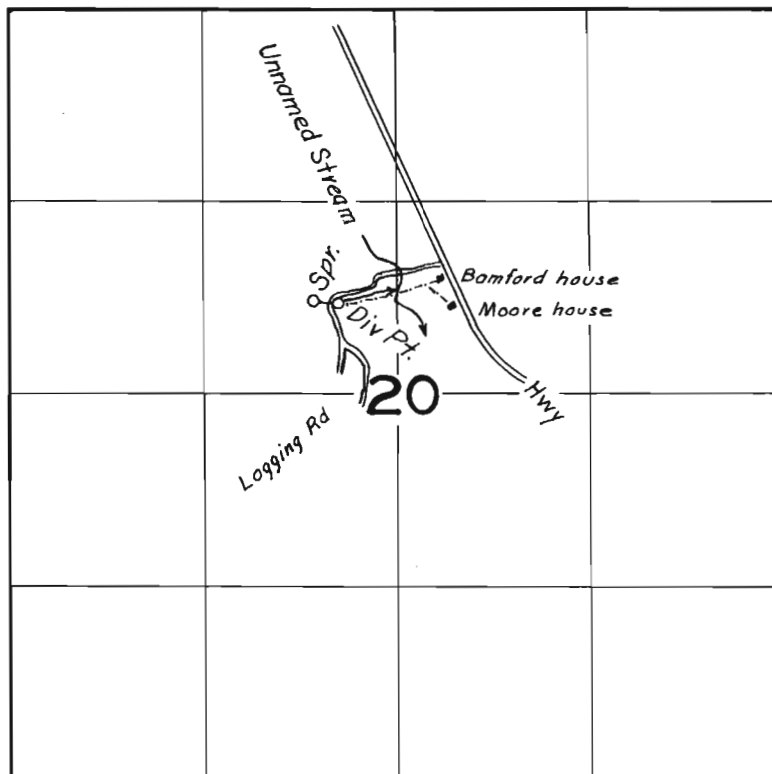

FINAL PROOF SURVEY
UNDER

Application No. 21199 Permit No. 16616
IN NAME OF

Ray R. Moore and Ellwyn H. Bamford

Surveyed April 23 1954 by H. L. Coffman