


U-213
U-239
16894
18164

T. R. W.M.

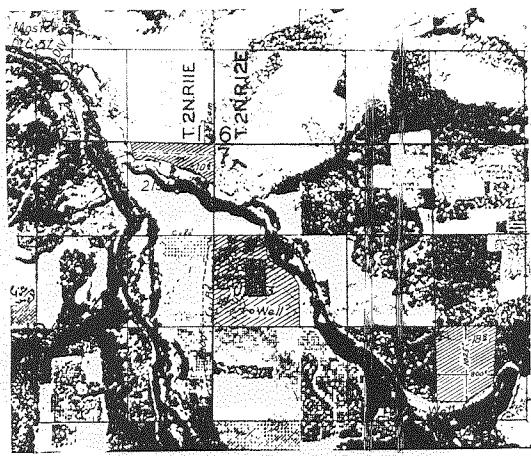

FINAL PROOF SURVEY

...

Surveyed ... 19... by ...