


T.18S.R.3W.W.M.

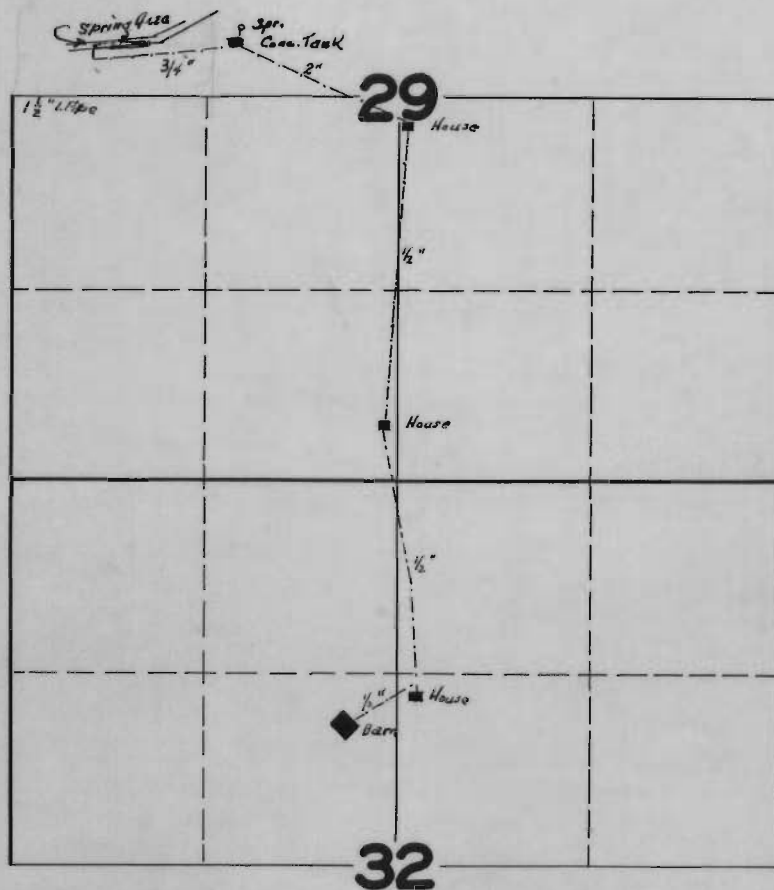

FINAL PROOF SURVEY
UNDER

Application No. 21718 Permit No. 17101
IN NAME OF

Mollie M. Christiansen

Surveyed July 22 1948, by J. B. Burnell