


T.29S.R.8W.WM

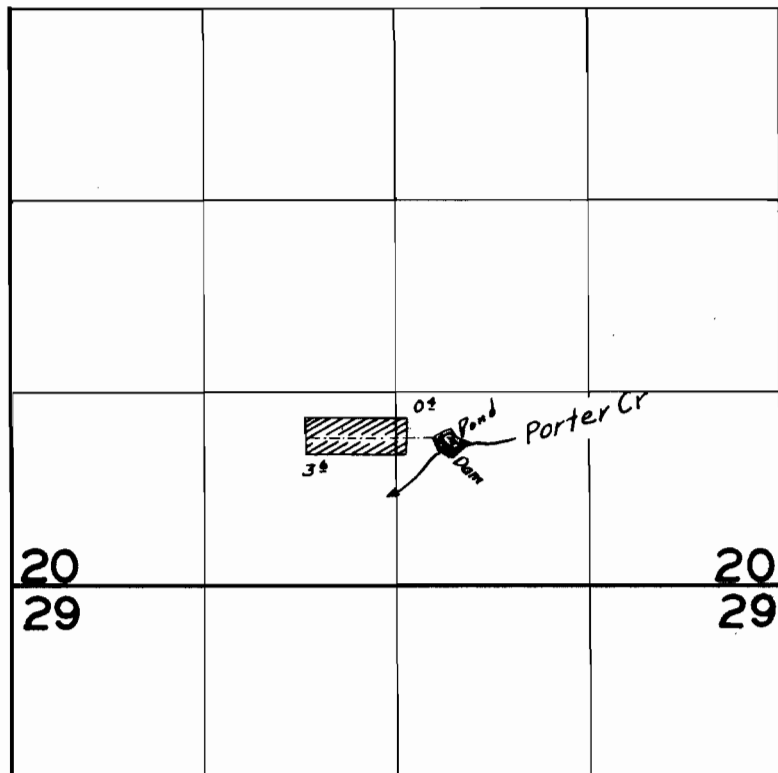

FINAL PROOF SURVEY
UNDER

Application No. 21879..... Permit No. 17203.....
IN NAME OF

part Colgart.....

Surveyed July 22, 1954, by T. Jones.....