


T.37S.R.14W.WM

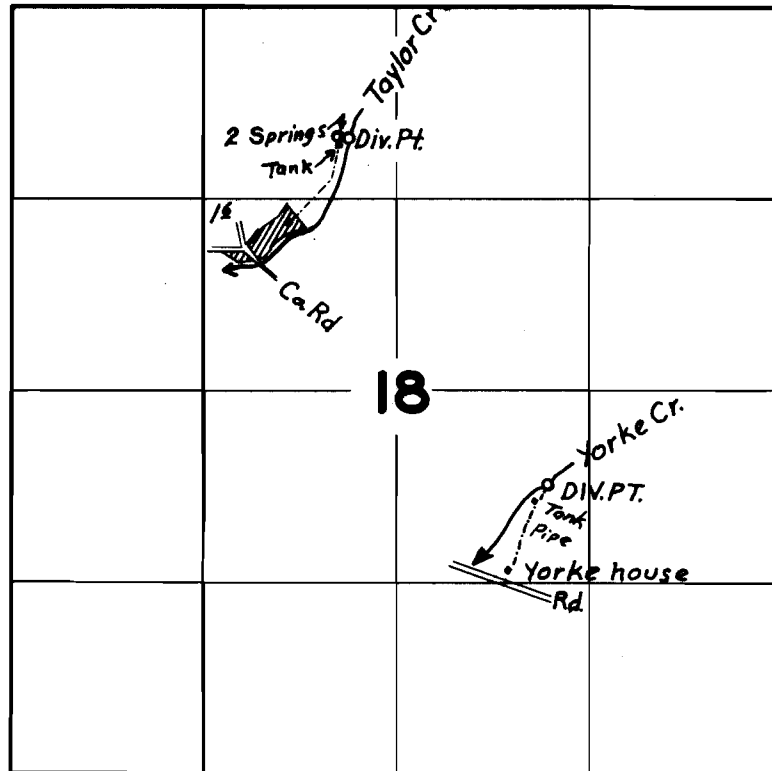

FINAL PROOF SURVEY

UNDER

24132

18996

Application No. 21905 Permit No. 17245

IN NAME OF

Curtis E. & Virginia F. Yorke

J.A. and Alma H. Goertzen

Surveyed Sept 15 1953, by T. Jones

1953-Y