


T.7S.R.29E.W.M

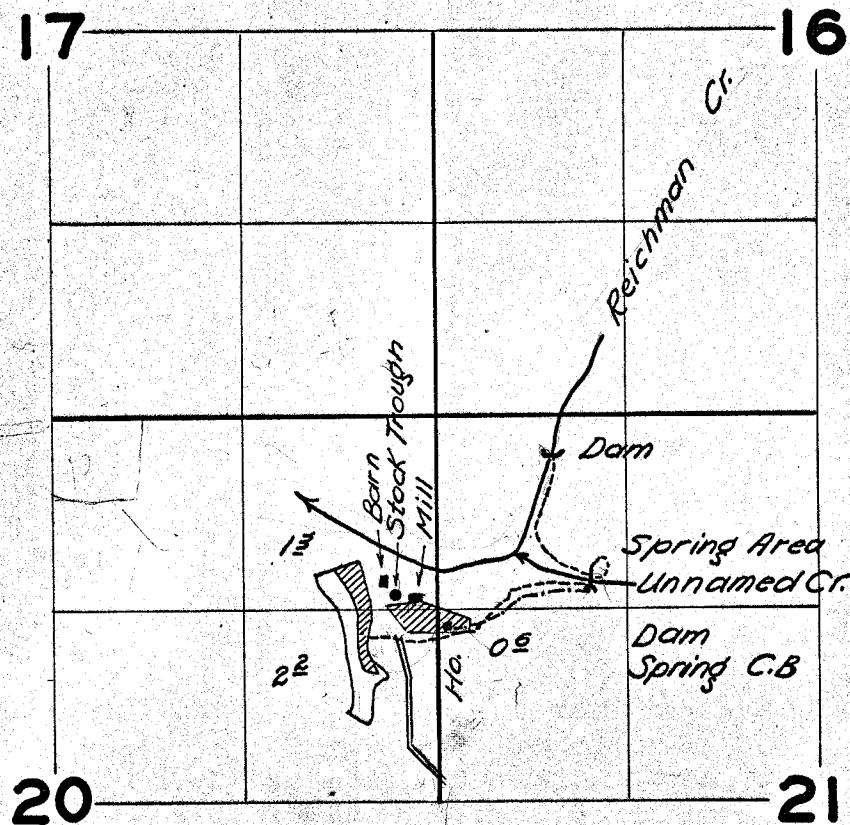

FINAL PROOF SURVEY UNDER

Application No. 21832... Permit No. 17391.....
IN NAME OF

.....L. W. Robertson.....

Surveyed Aug. 27, 1954., by H. L. Coffman.

BTU-21-84
Pantograph