


T.17S.R.2W.WM

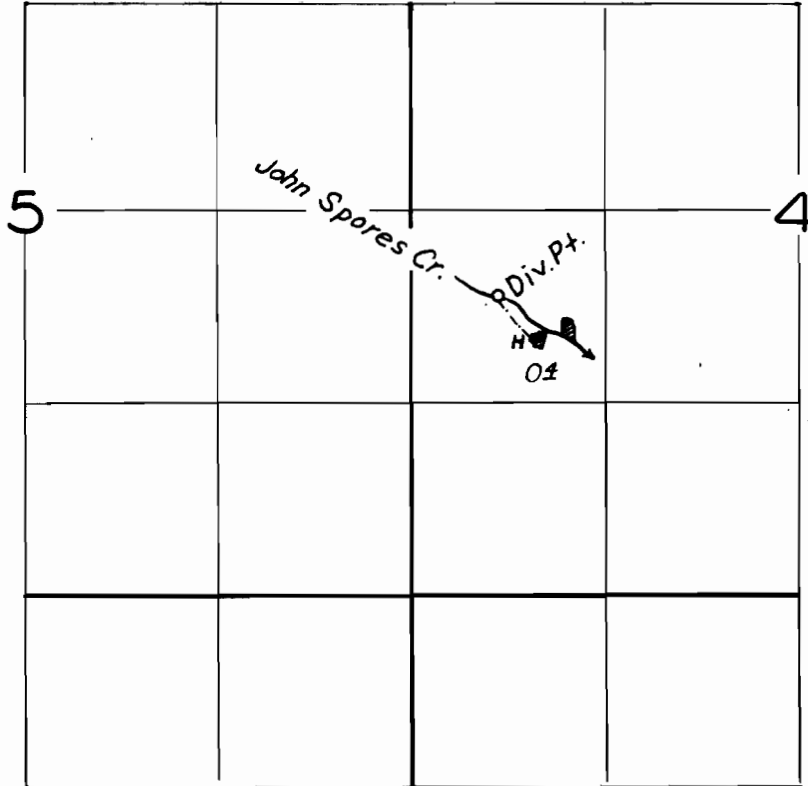

FINAL PROOF SURVEY
UNDER

Application No. 2175 Permit No. 17403
IN NAME OF

John D. and Robert H. L.

Surveyed April 1951, by W. A. D. D.