


T.17S.R.6W.W.M.

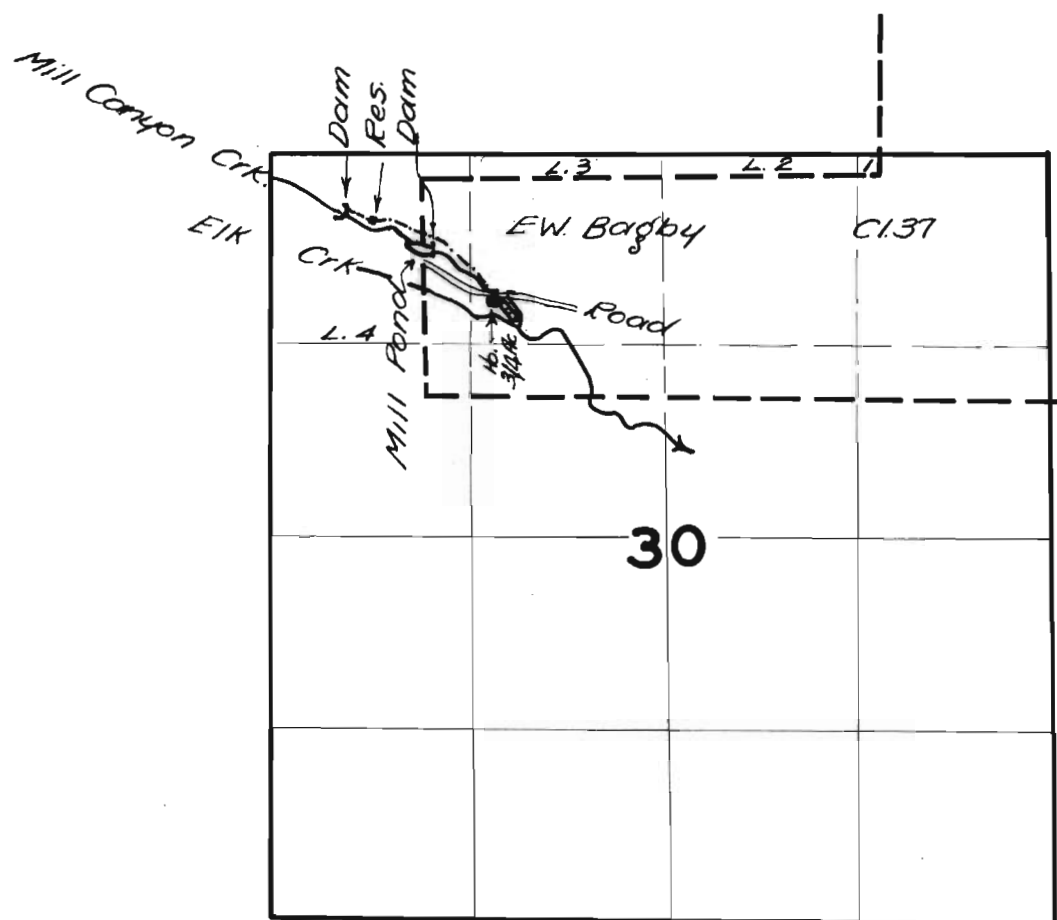

FINAL PROOF SURVEY

UNDER

Application No. 22286 Permit No. 17575

IN NAME OF

Martin C. Montgomery

Surveyed April 26 1954 by H. L. Coffman