


T.13S.R.1E.W.M

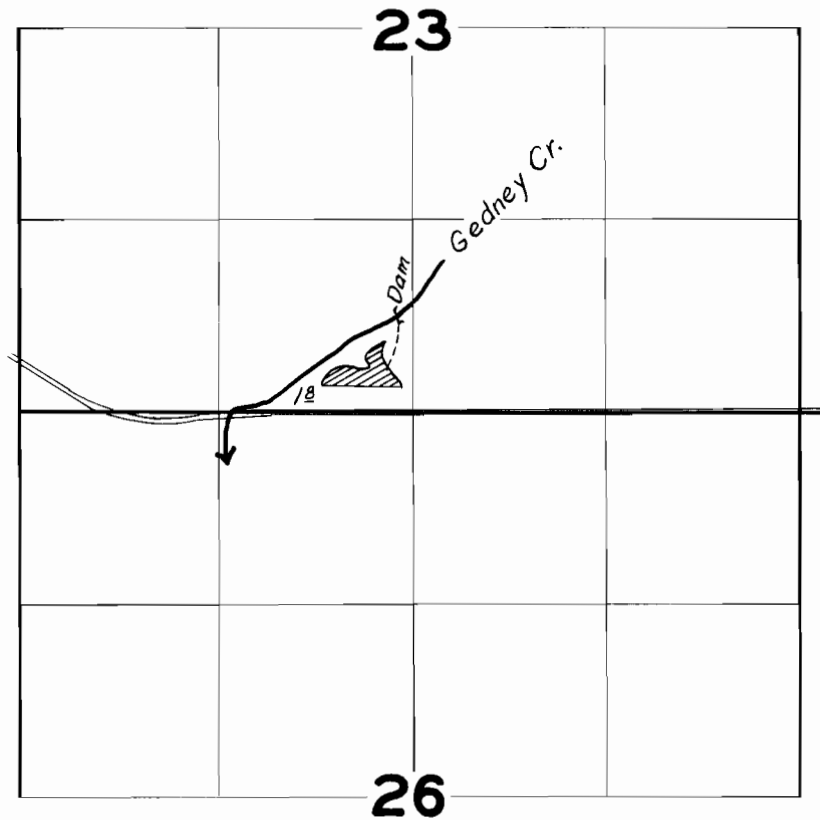

FINAL PROOF SURVEY

UNDER

Application No. 22628 Permit No. 17792...

IN NAME OF

Geo. J. Kraft

Surveyed Aug. 19 19 54, by H. L. Coffman.