


# T.8S.R.5W. WM

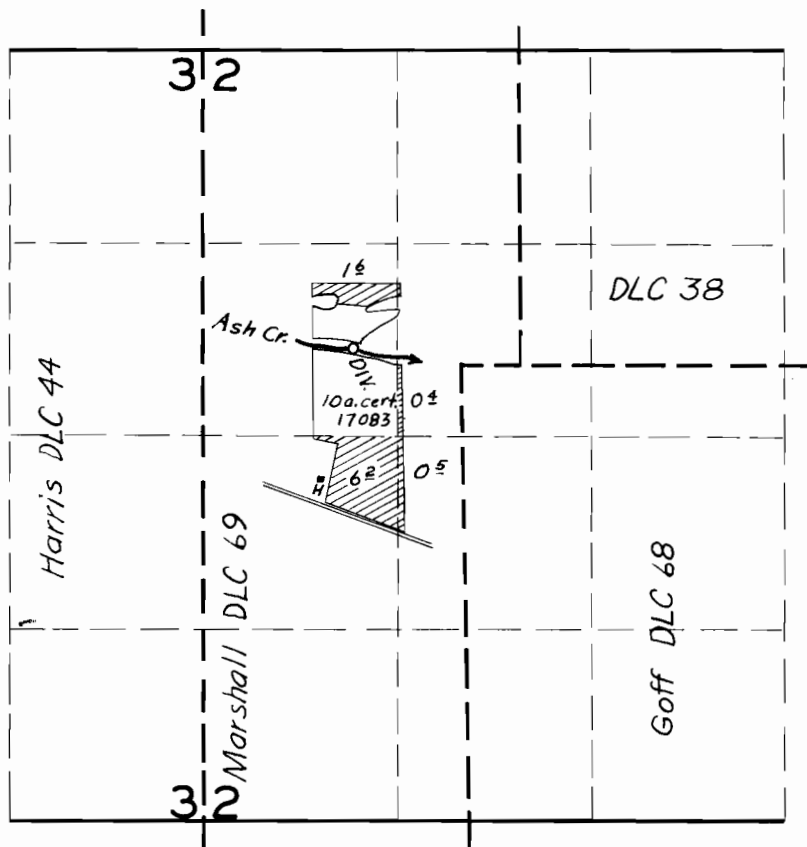

## FINAL PROOF SURVEY UNDER

Application No. 22713 ... Permit No. 17850  
IN NAME OF

..... David D. Giesbrecht .....

Surveyed Aug. 5 19 54, by T. Jones .....