


T. 3 S. R. 40 E. WM

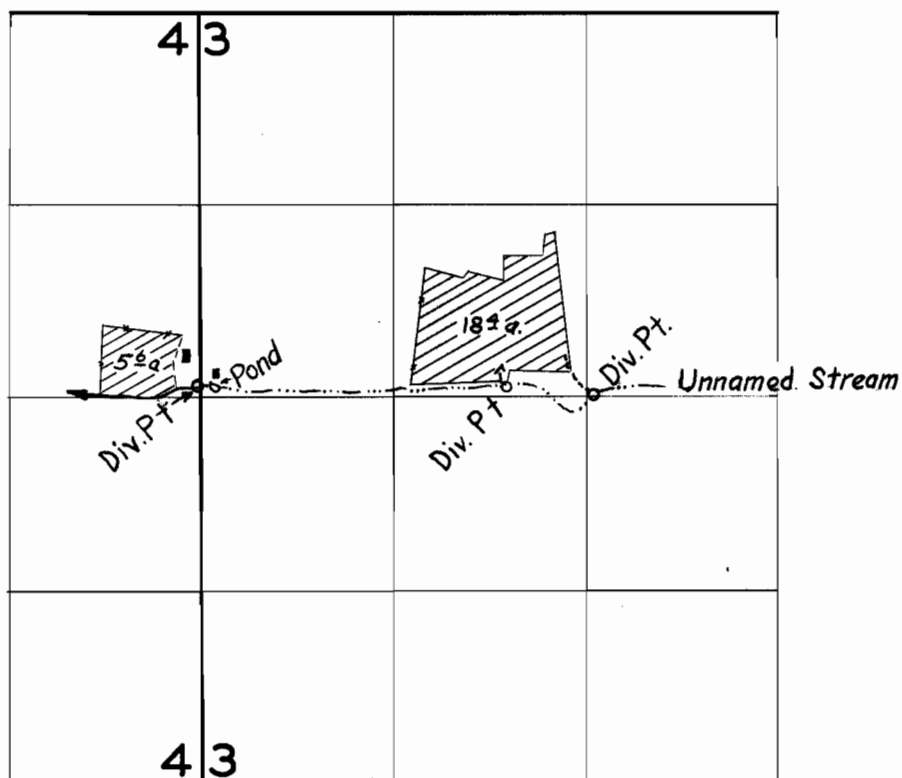

FINAL PROOF SURVEY

UNDER

Application No. 23105..... Permit No. 18212.....

IN NAME OF

William C. Curteman.....

Surveyed Oct. 7, 1953, by H. L. Coffman.....