


T. 22 S., R. 32 E., W.M.

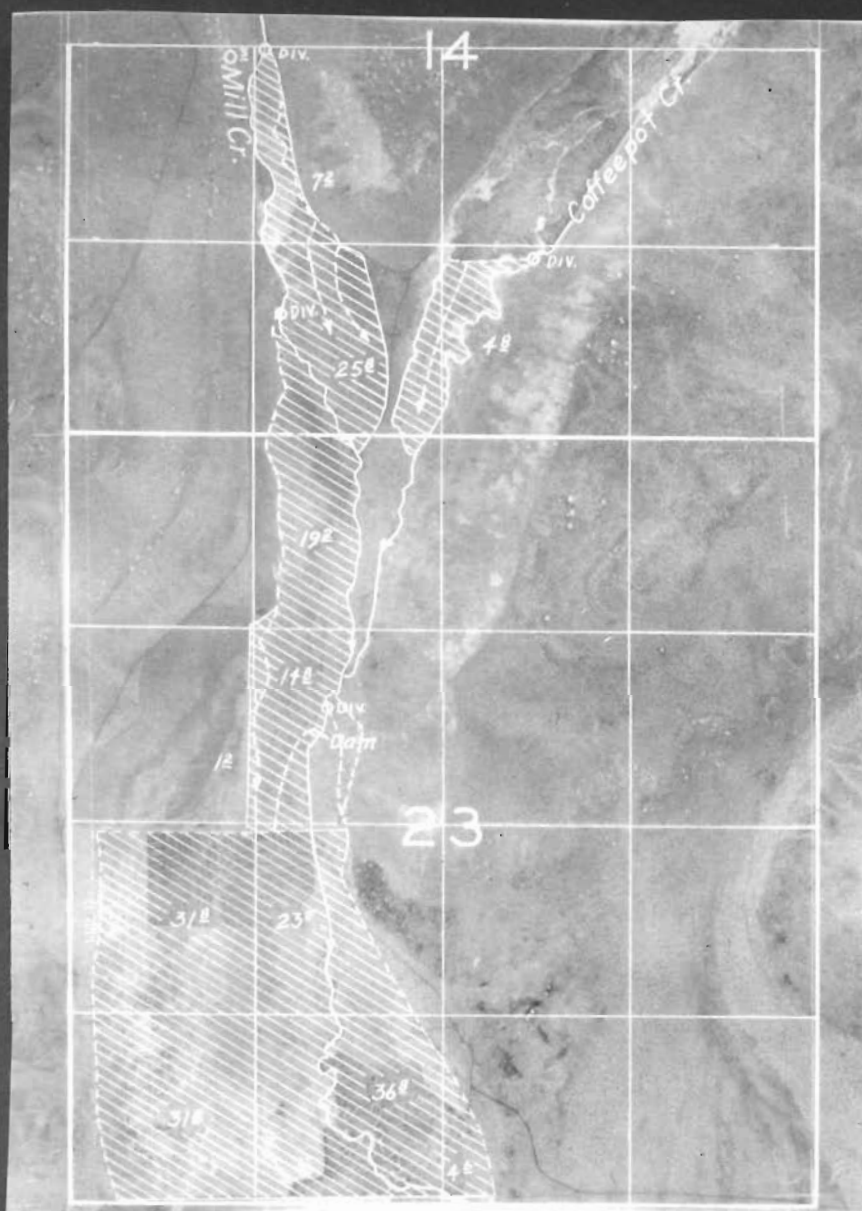

FINAL PROOF SURVEY
UNDER

Application No. 22660..... Permit No. 17886.....
IN NAME OF

.....Ralph E. Reed.....

Surveyed June 28, 1954, by T. Jones.....

H2-7-8