


T. 22 S. R. 3 W. WM

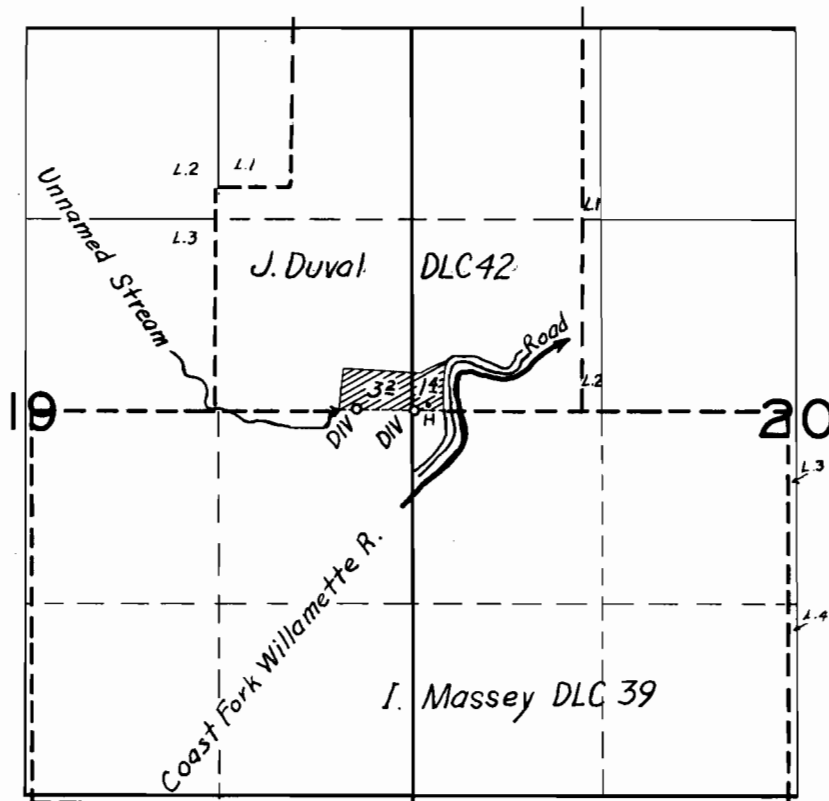

FINAL PROOF SURVEY
UNDER

Application No. 14193 Permit No. 14197
IN NAME OF

Geo. A. Gally Latherland

Surveyed Mar 11 1911, by A. Jones