
T. R. . W.M.

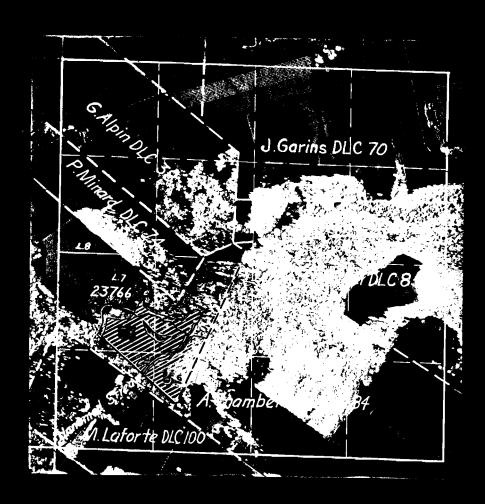

FINAL PROOF SURVEY

UNDER

Application No. Permit No. IN NAME OF

Surveyed

19. , by