


P18762  
21085

# T.13S.R. 26E.W.M.

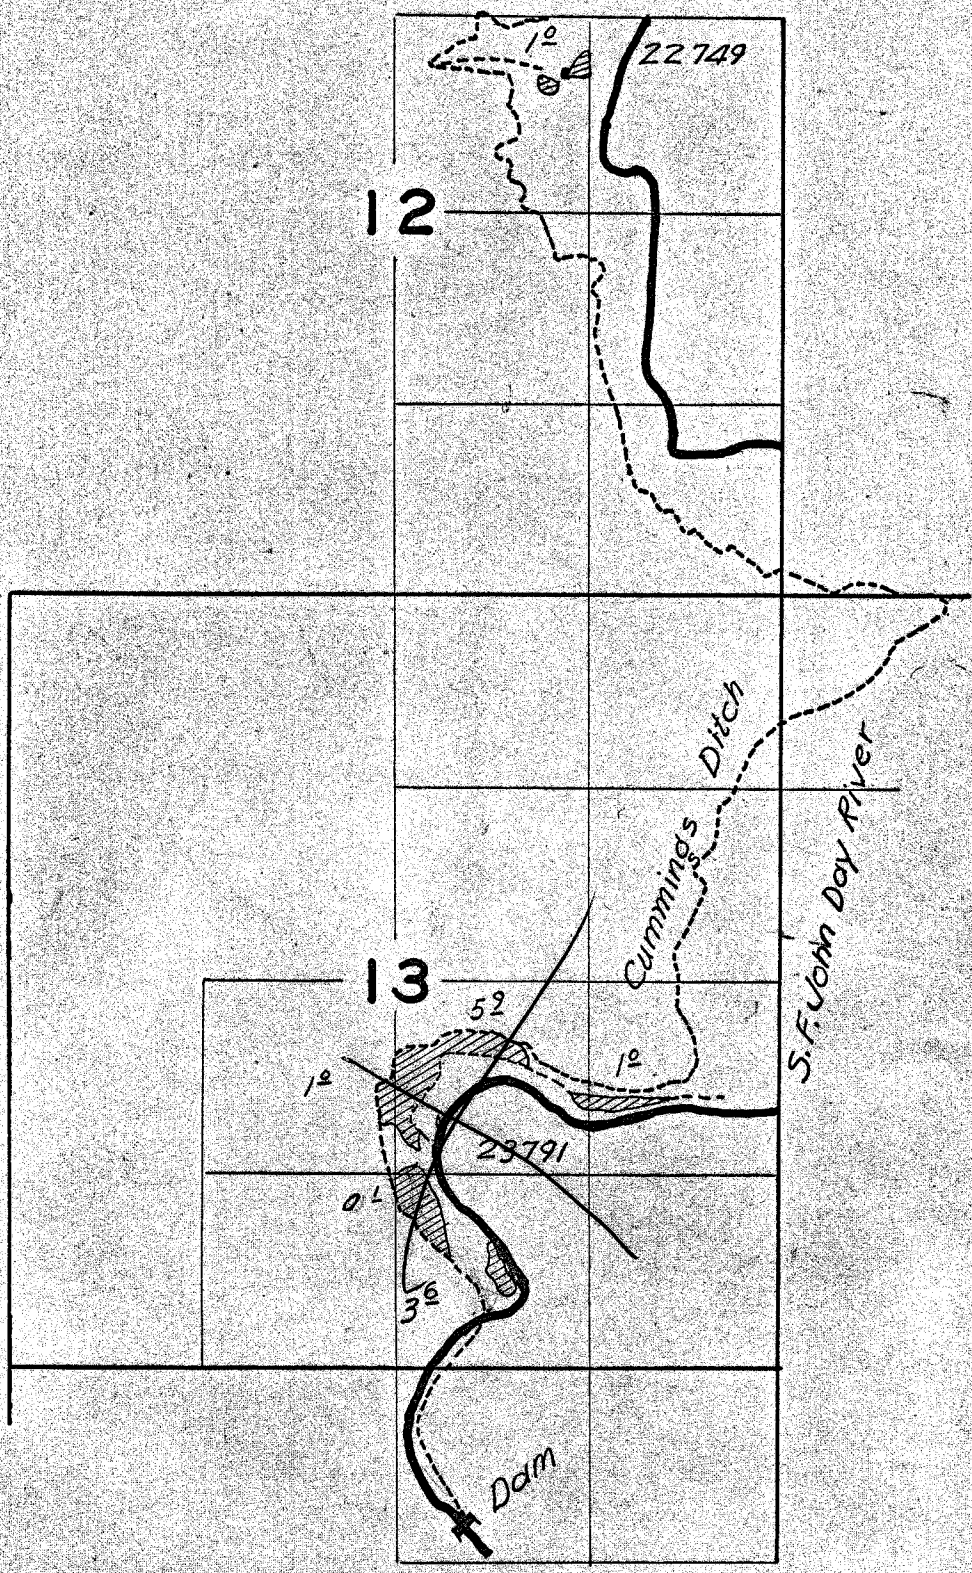

## FINAL PROOF SURVEY

George S. Black	Appl. 22749	Permit 17862
Geo. MacArthur	23791	18768

24

Surveyed August 29, 1954 by H. L. Coffman

G6-4  
G5-7  
Pantograph