


# T.10S.R.1W.WM

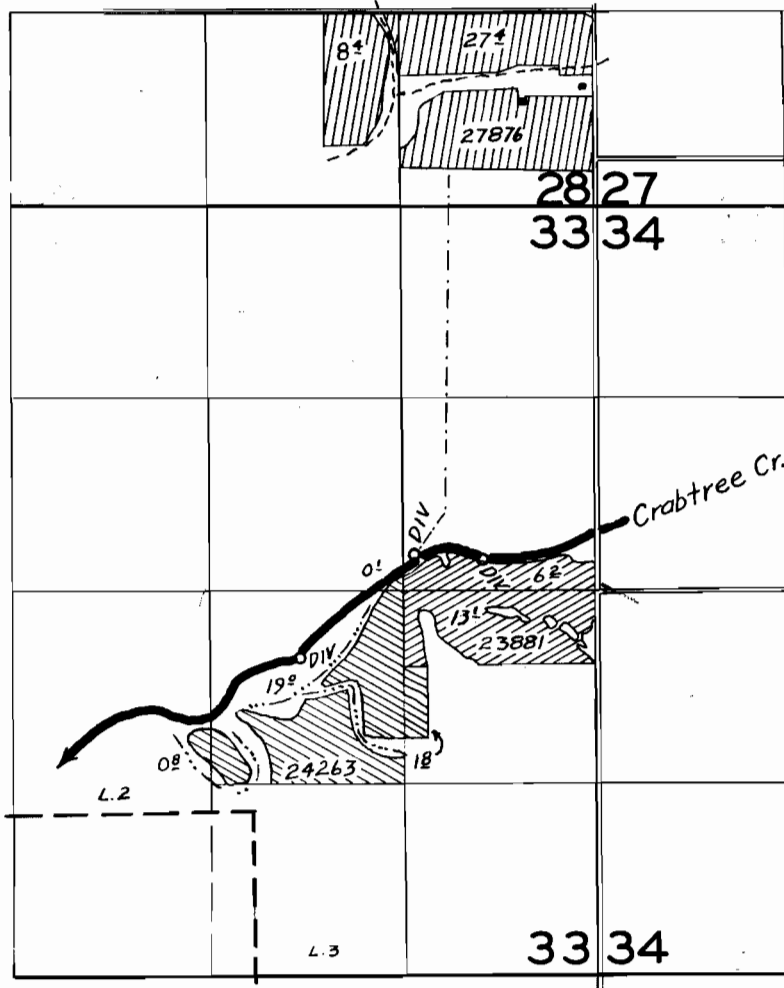

## FINAL PROOF SURVEY

24263                      19215  
 23881                      18797  
 Application No. 27876    Permit No. 21963

Ollin L. Wood  
 Geo. H. and Lena Truman  
 Jim & Helena Krosman

Surveyed July 12 1954, by H. L. Coffman