


T. 6 S. R. 6 W. WM

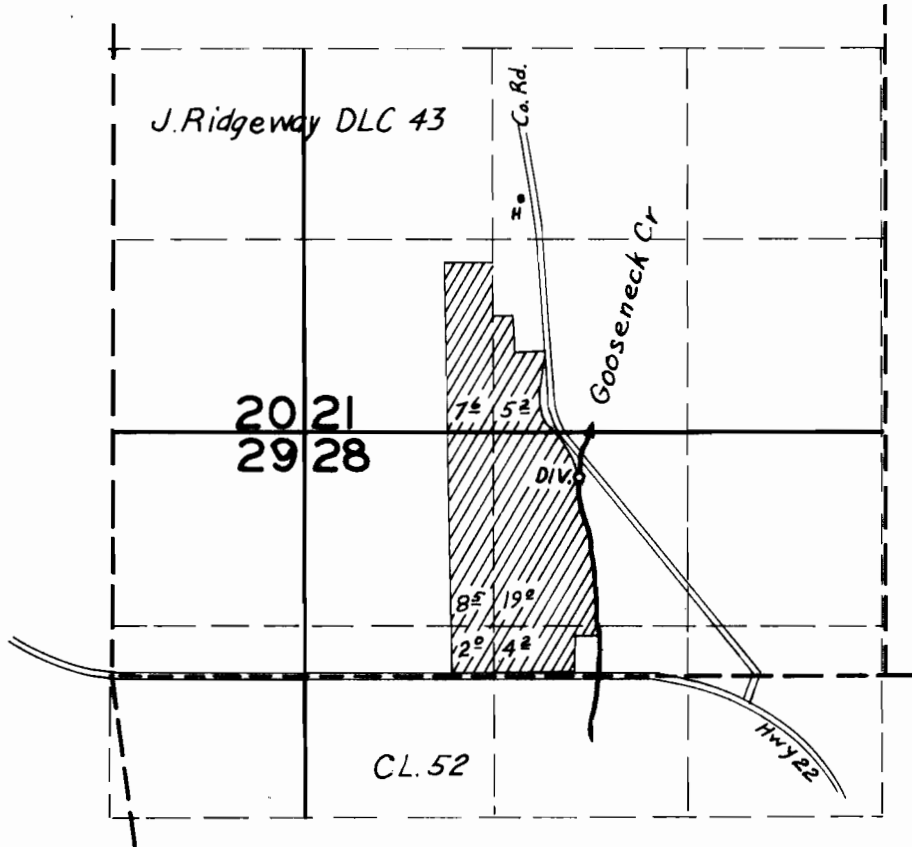

FINAL PROOF SURVEY UNDER

Application No. 23828..... Permit No. 18888.....
IN NAME OF

G. D. Stewart

Surveyed July 12 19 54, by T. Jones

DFP-3D-70