


T.21 S., R. 2 W., W.M.

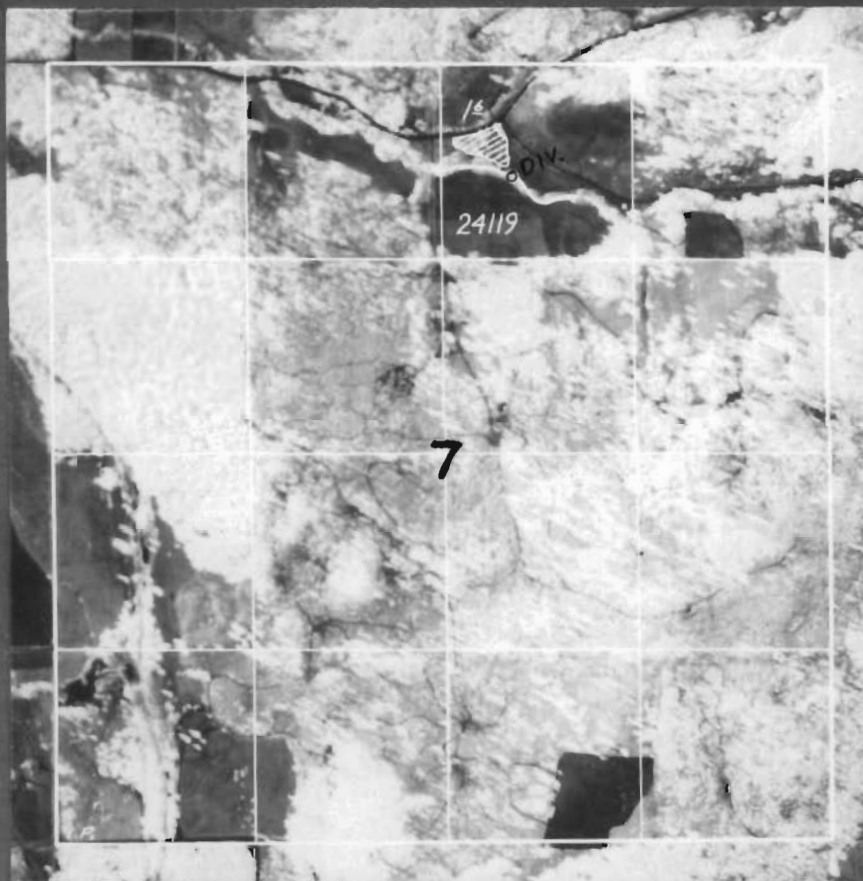

FINAL PROOF SURVEY
UNDER

Application No. 24119 Permit No. 18988
IN NAME OF

Fred V. Overton and Ada M. Overton

Surveyed May 4, 1954, by T. Jones

DBO-5H-121