


T.9S.R.6W.WM

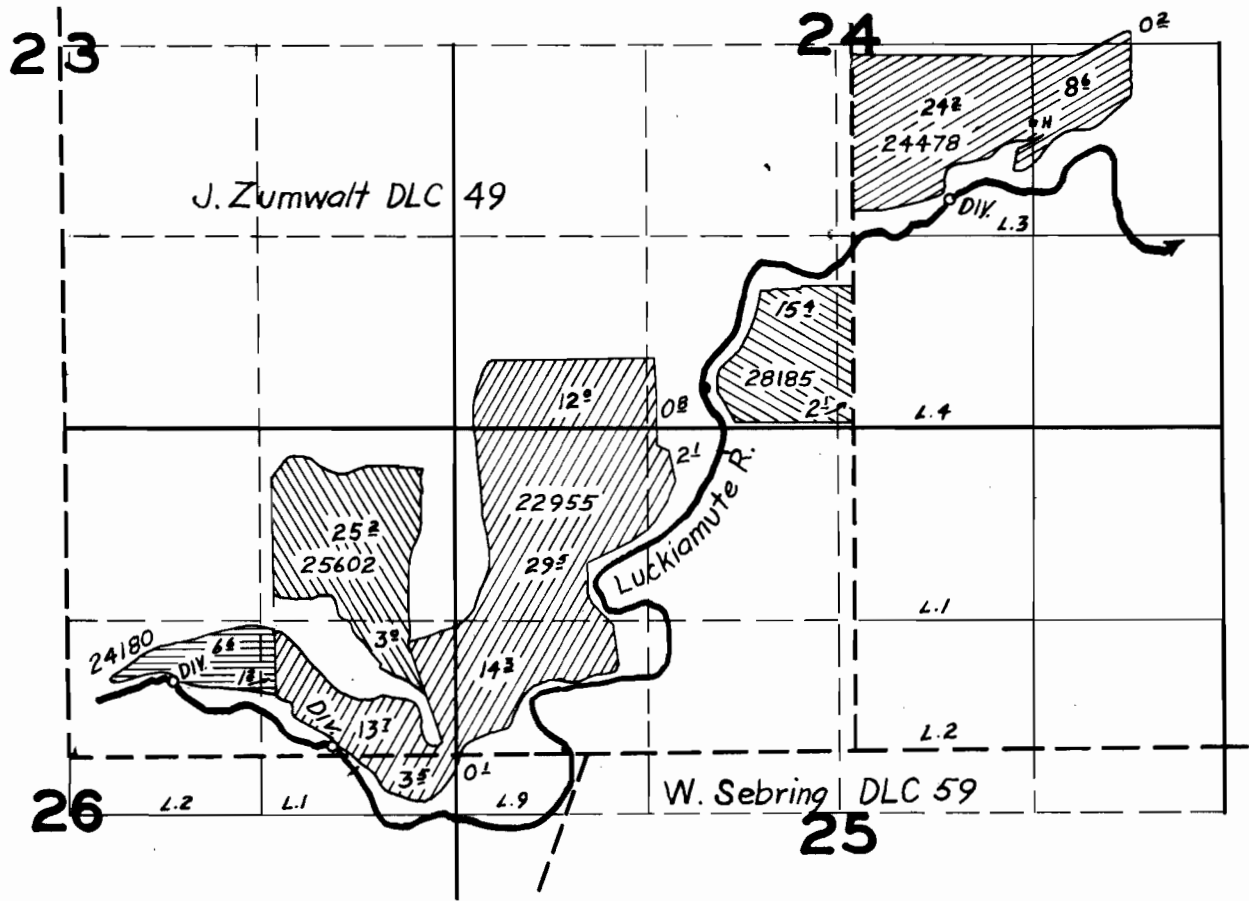

FINAL PROOF SURVEY

Application No.	24180	24478	25602	22955	28185	19015	19319	20039	18189	22641
-----------------	-------	-------	-------	-------	-------	-------	-------	-------	-------	-------

IN NAME OF

Herman Amos, Kenneth F. Richards, E. M. Cates
 E. M. Cates, E. M. Cates

Surveyed July 13-14 1954, by T. Jones