T.7S.R.1E.WM

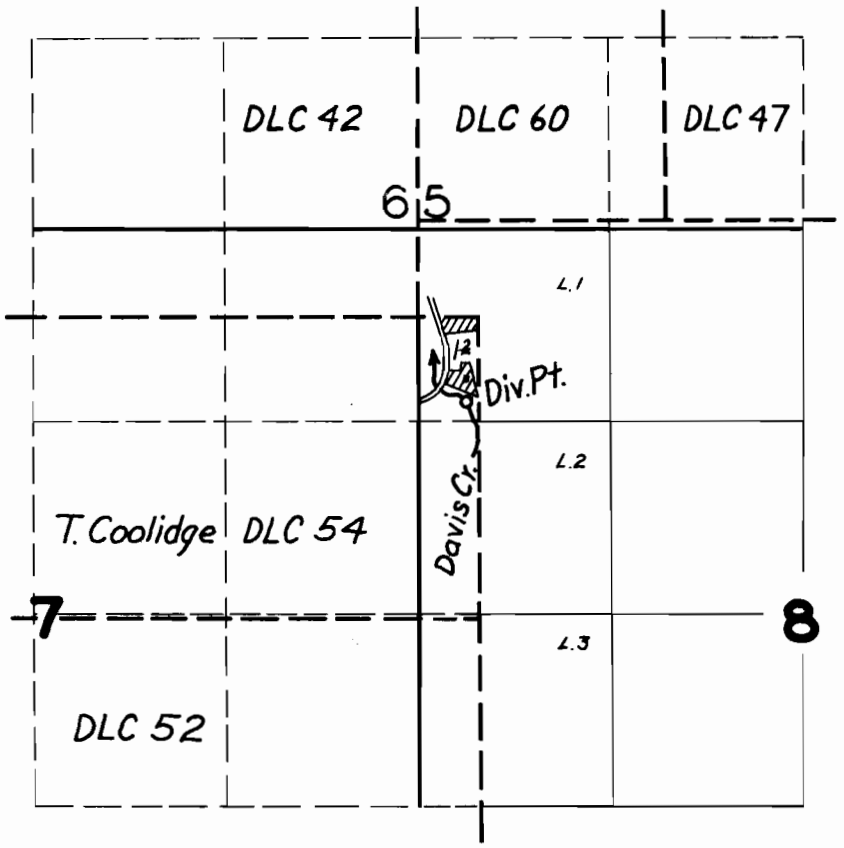

FINAL PROOF SURVEY

UNDER

Application No. 24194 Permit No. 19022

IN NAME OF

Alvin Sweger

Surveyed May 27 1954, by H. Jones

1954-Z