


T. 17 & 18 S. R. 2 W. W. M

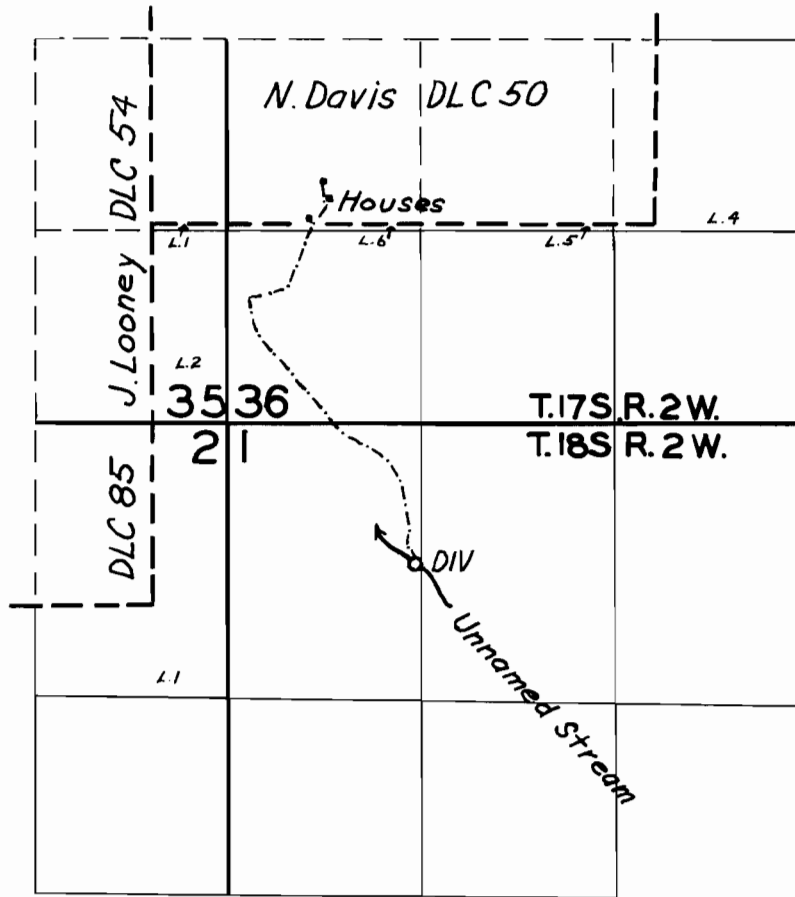

FINAL PROOF SURVEY

UNDER

Application No. 20201 Permit No. 20201

IN NAME OF

Clifford Macy

Surveyed 2020 1951, by mas