


T.19.S R.4.W.W.M.

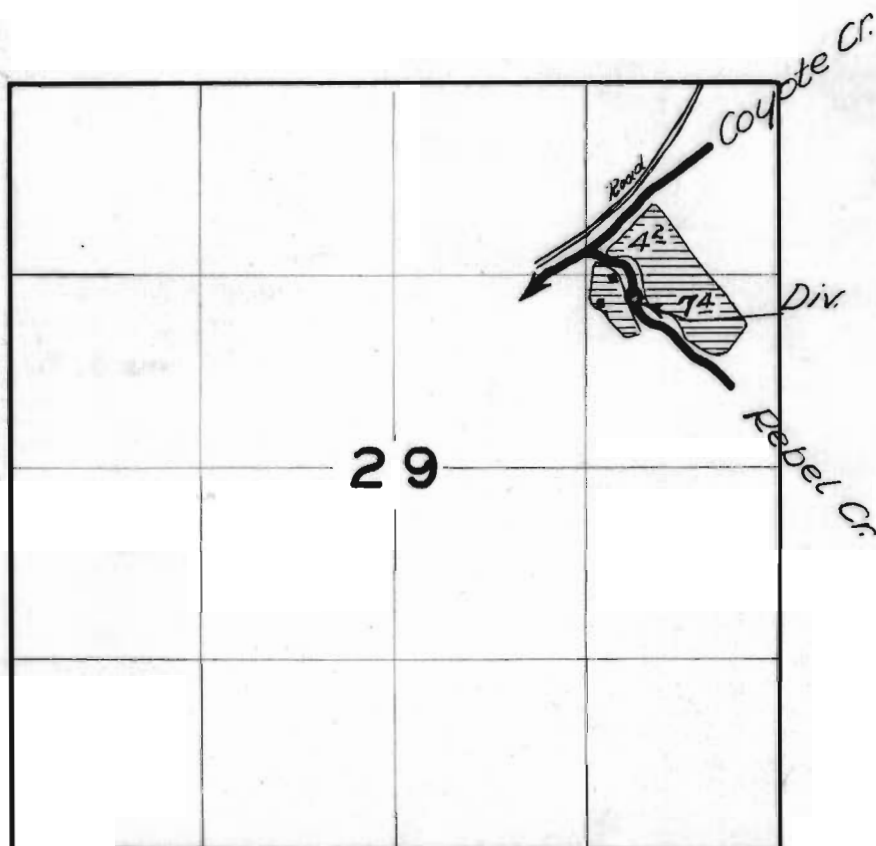

FINAL PROOF SURVEY

UNDER

Application No. 24275..... Permit No. 19048.....

IN NAME OF

Claude R. Mathes

Surveyed April 30 1954, by H. L. Coffman