


T.9S.R.3E.W.M.

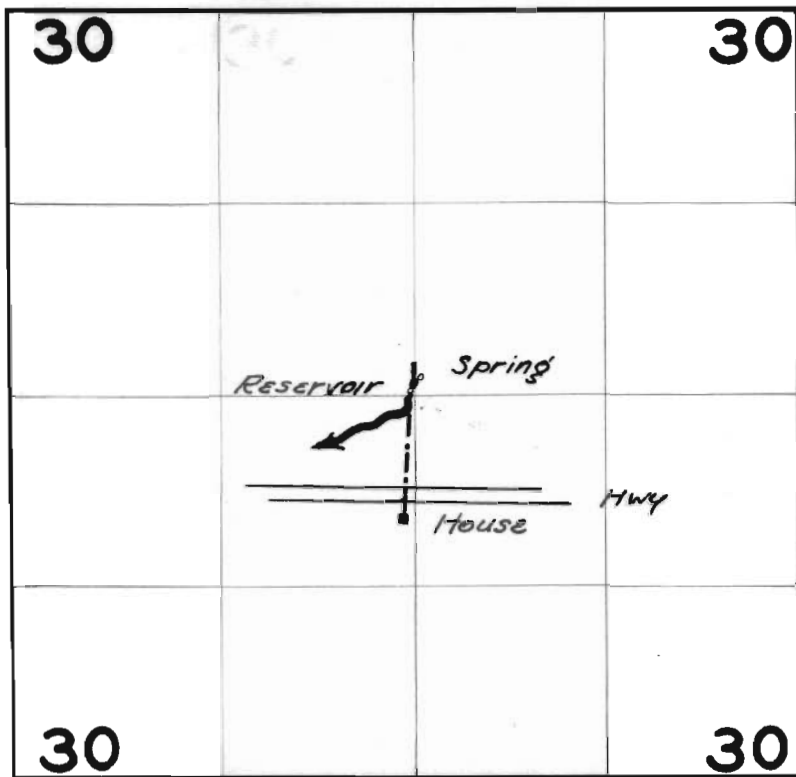

FINAL PROOF SURVEY
UNDER

Application No. 24320 Permit No. 19064
IN NAME OF

Edwin D. and Jennie V. Smith

Surveyed June 4, 1954, by H. L. Coffman