




S. , Range 26 E.W.M.

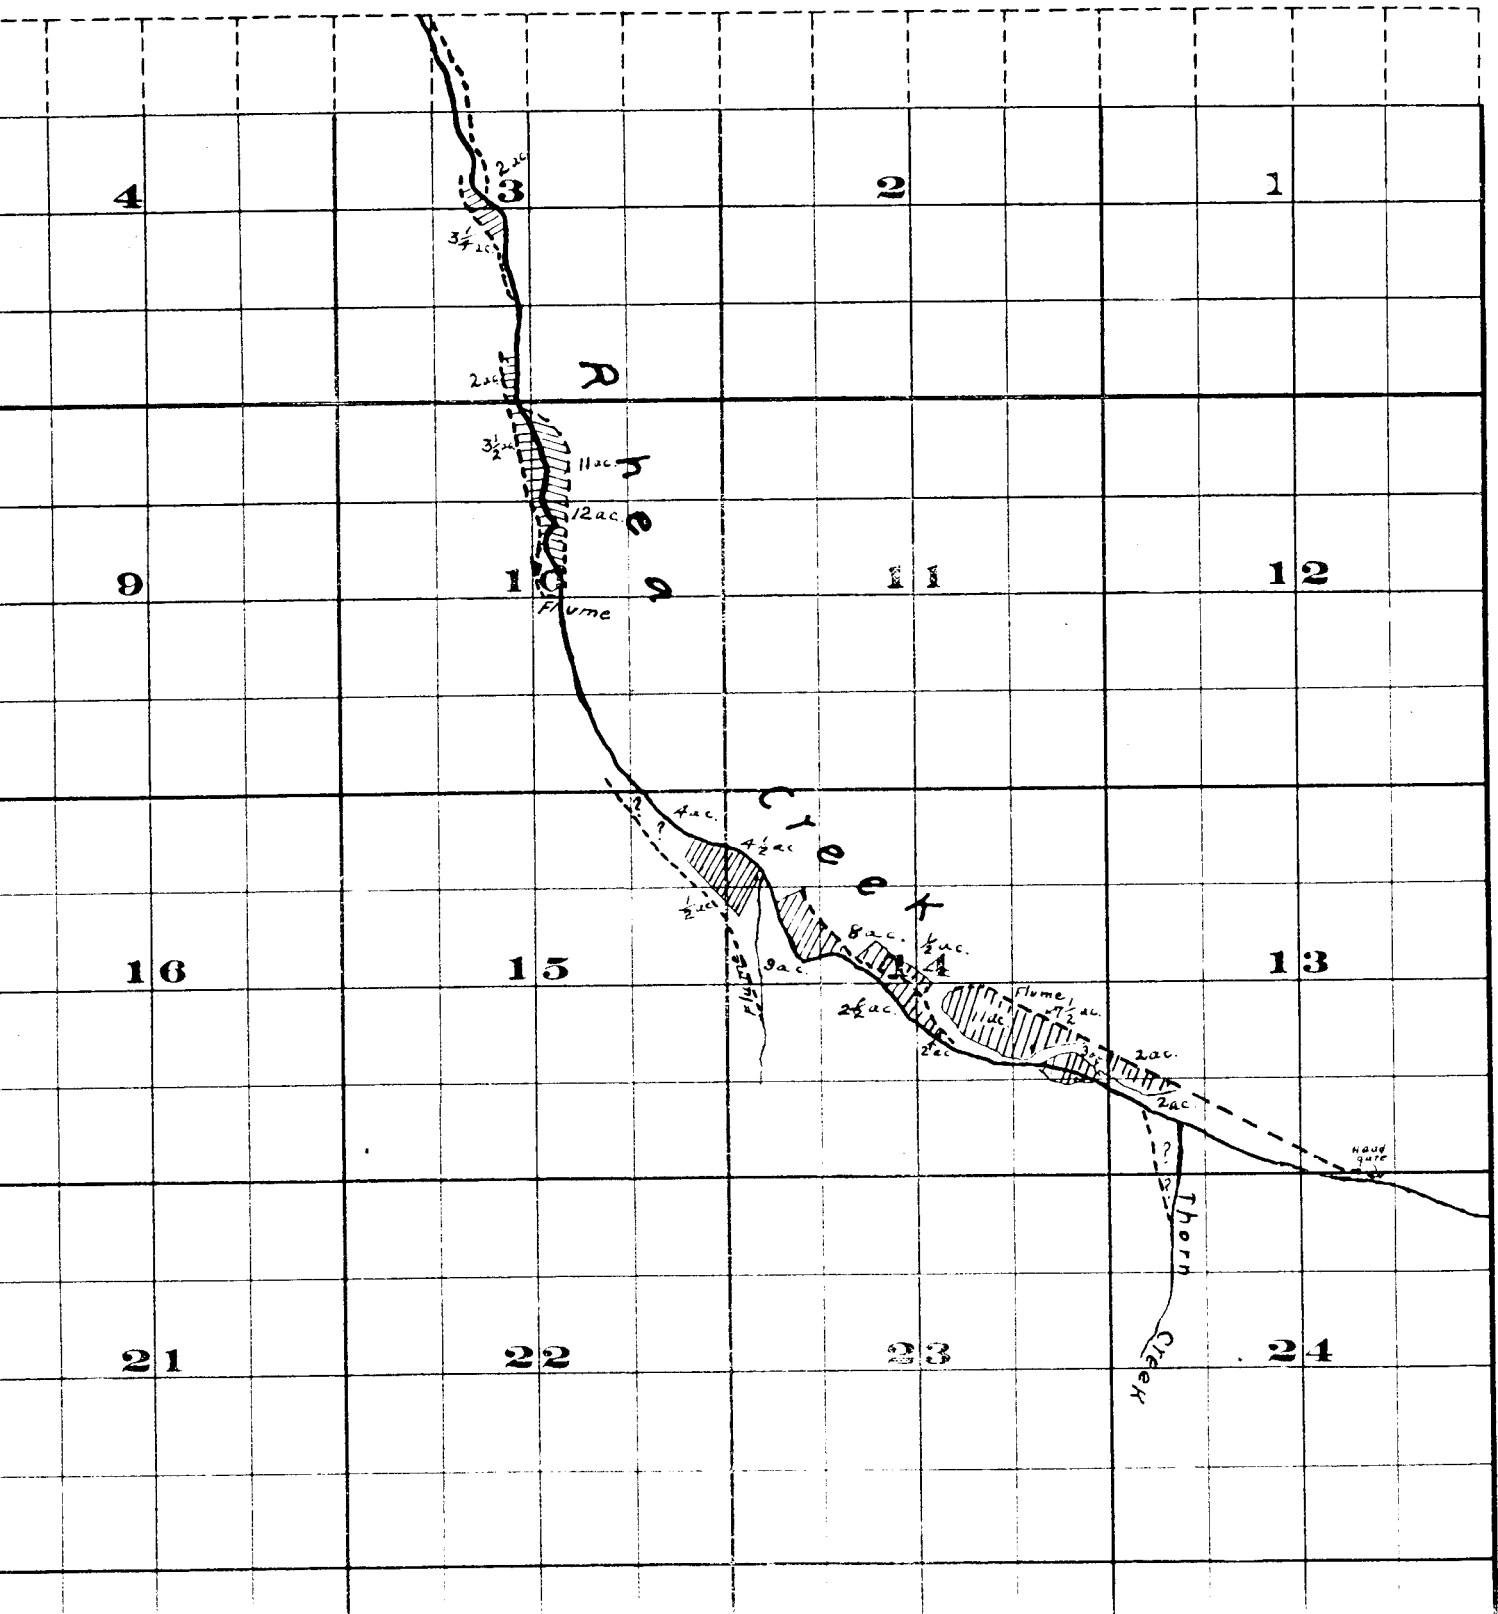

,

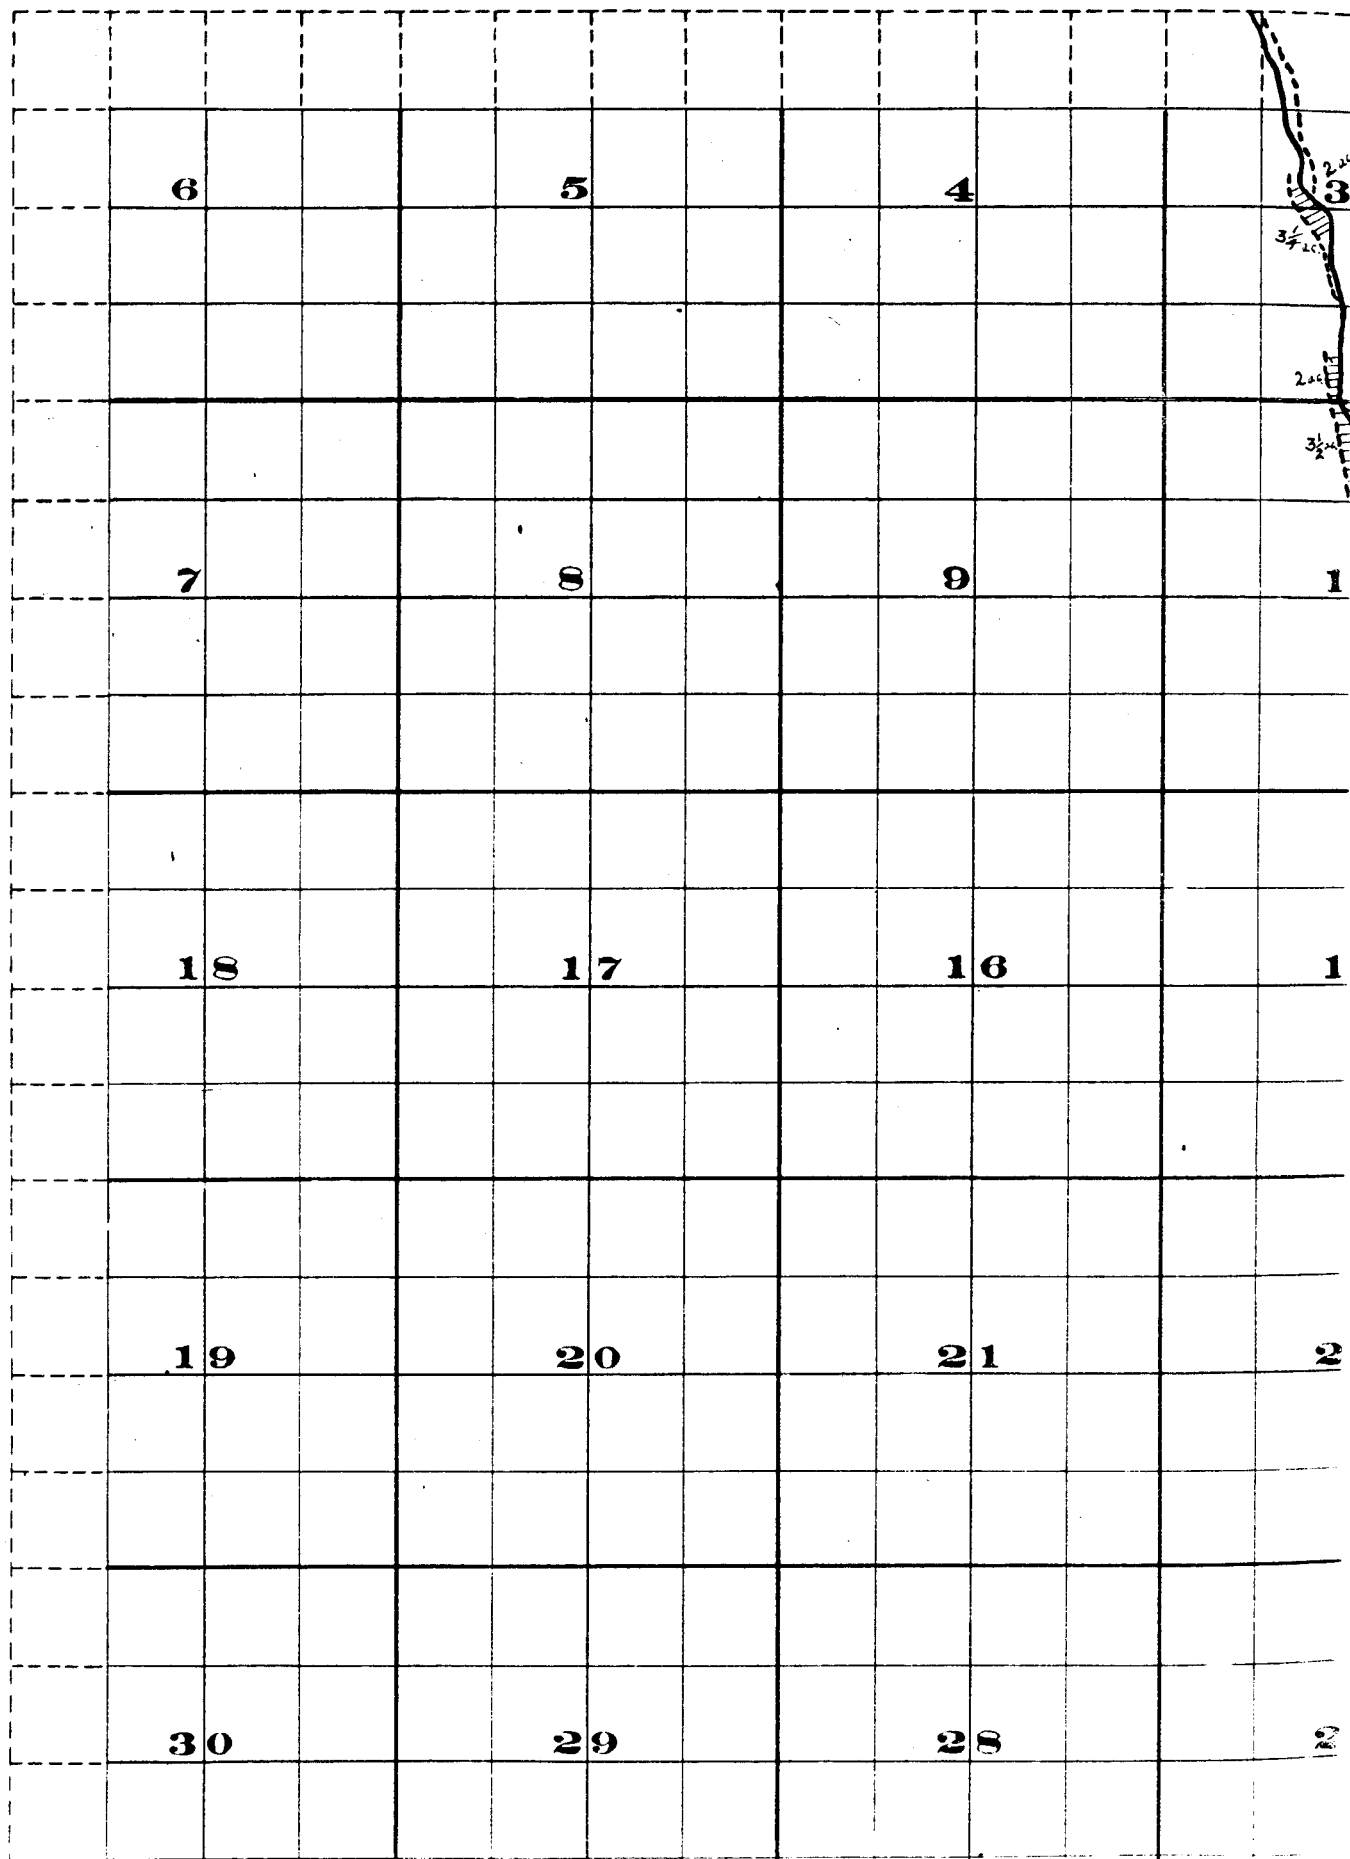

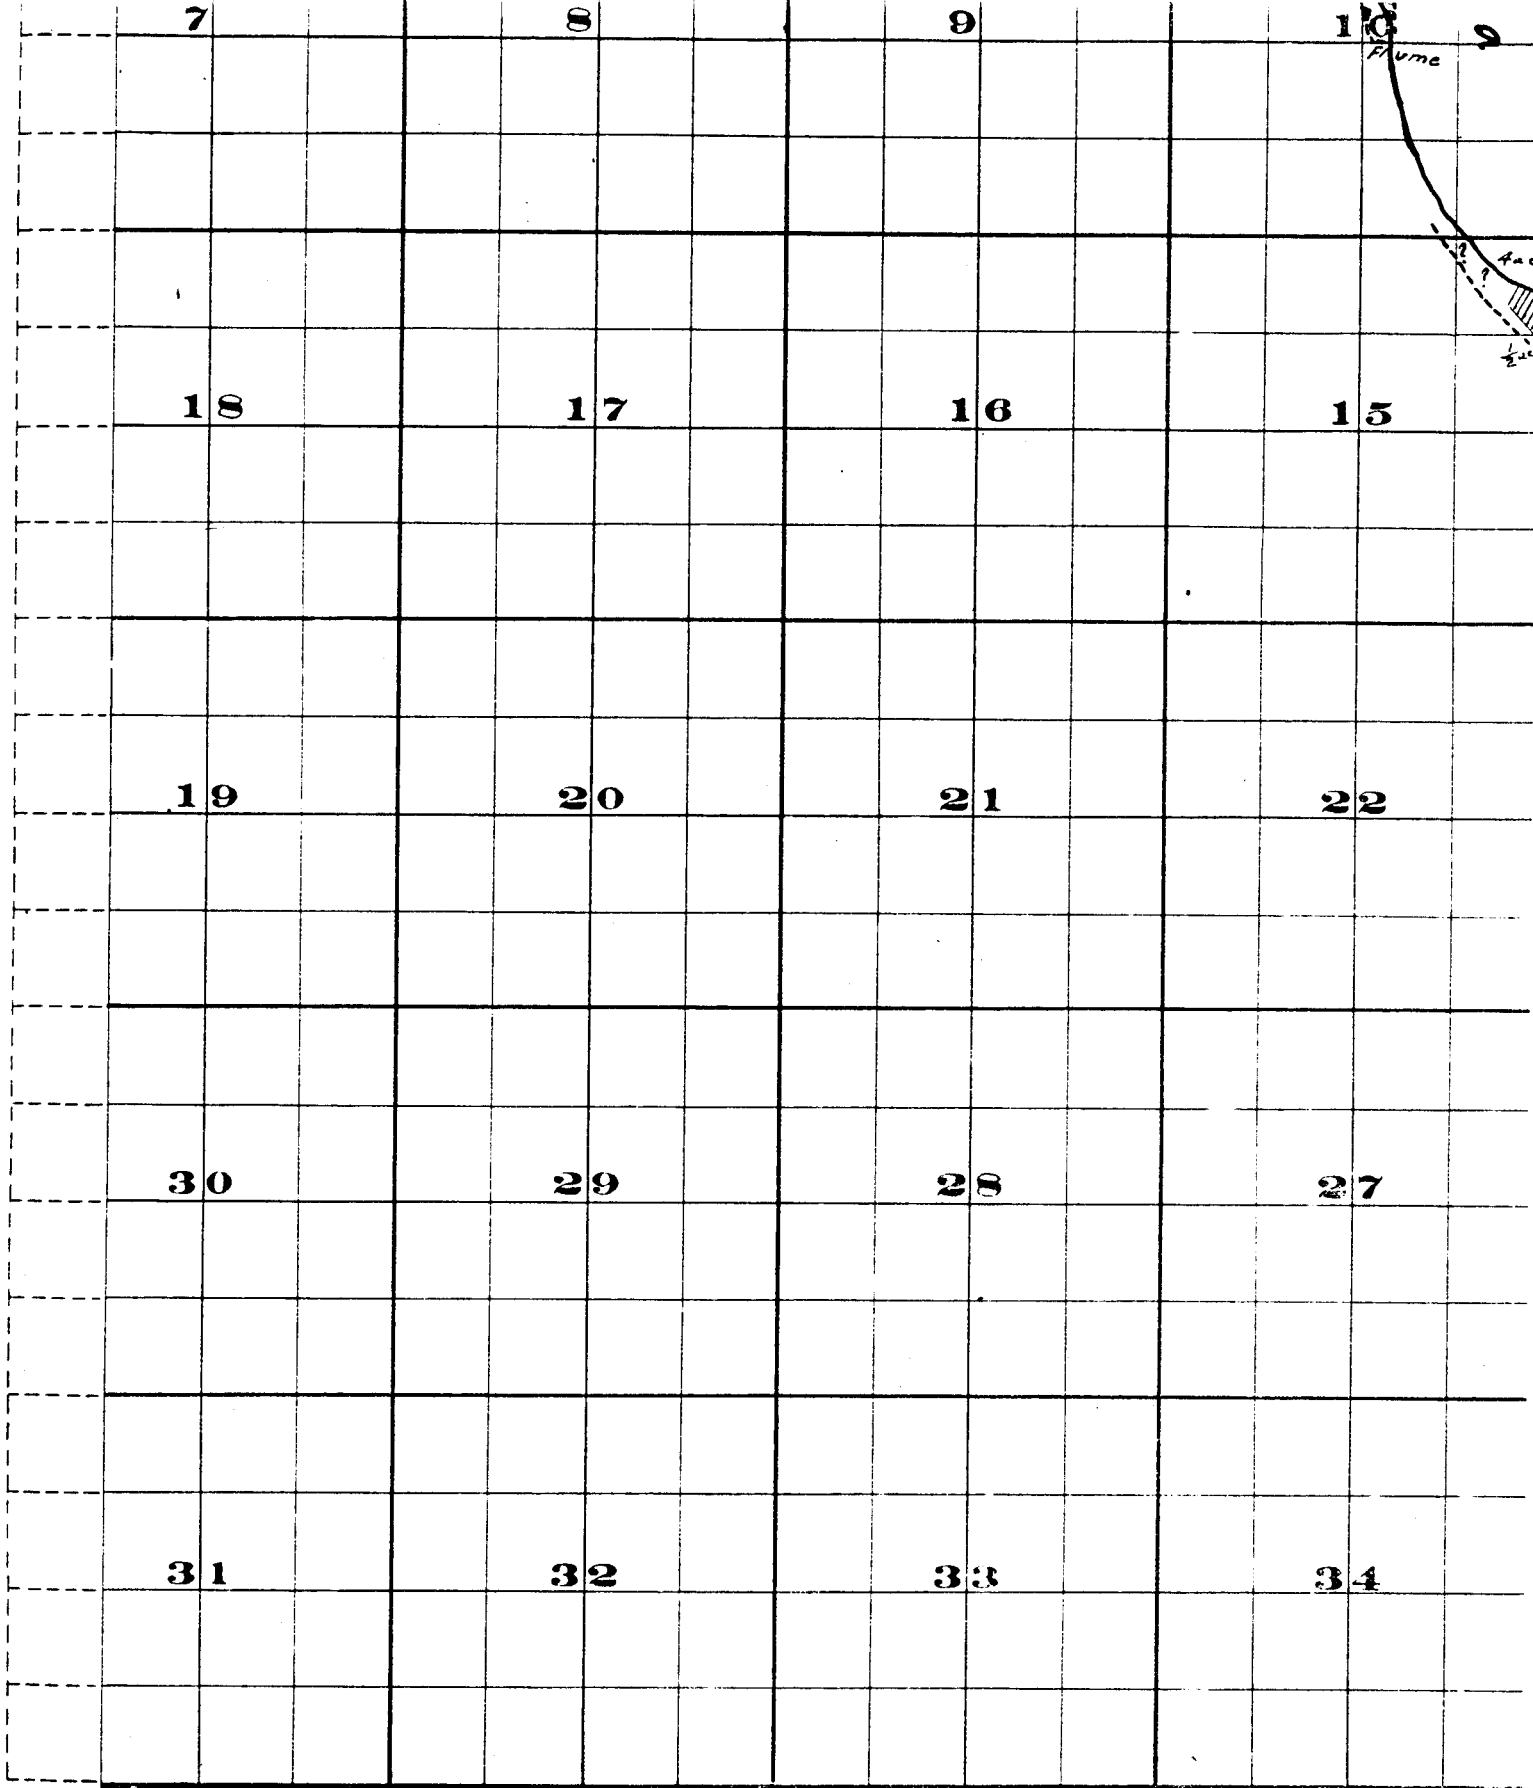


THE S. A. BRISTOL CO. PRINTERS & PUBLISHERS, CHICAGO, ILL.

Surveyed by H. K. Donnelly July 1909

John H. Lewis - State Engineer

Examined July 14, 1909.

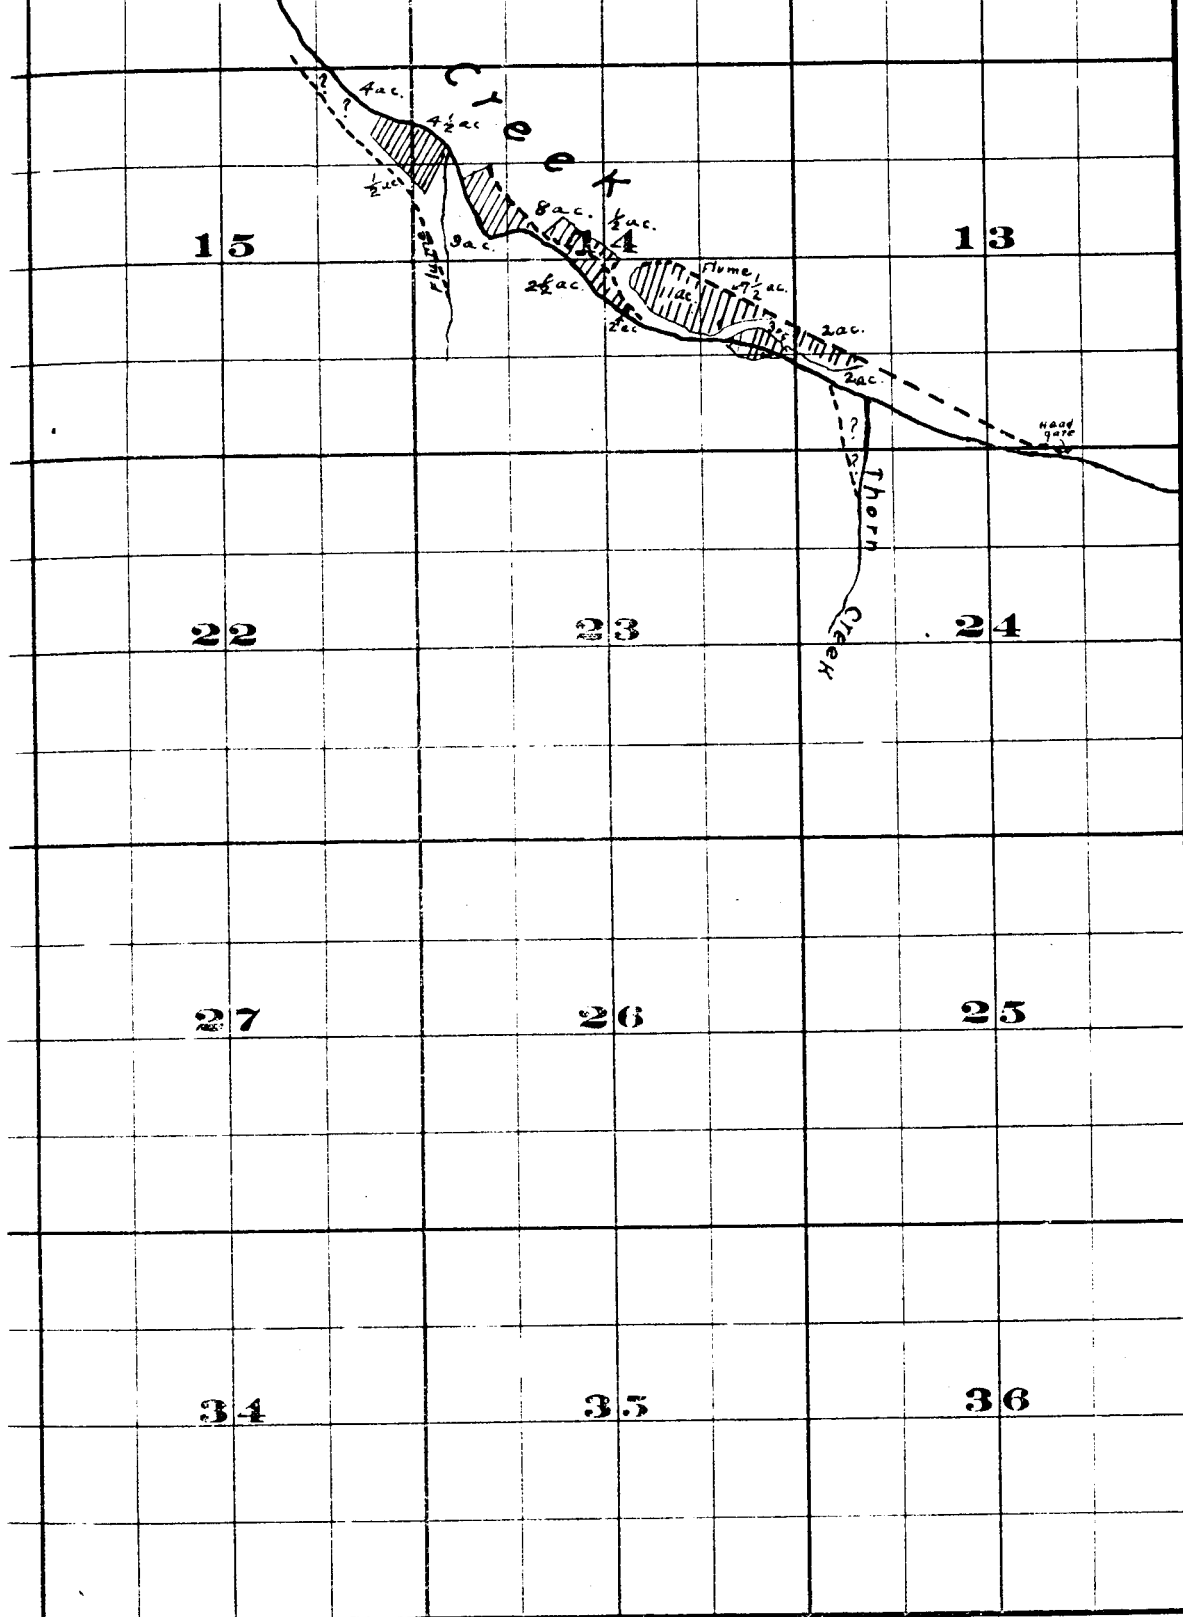

FROM OFFICE OF THE STATE ENGINEER, SALEM, OREGON

Willow Creek Adjudication

4 S. 26